

PART B

FIRE ENGINEERING
WALES

Fire Safety Design Review

Project Title Project Dragon - Sustainable Aviation Fuel (SAF) Production Facility

Client LanzaTech UK Limited

Written by Jessica Price

Reviewed by Jon Preston

Revision 01 **Date** 11.08.2023

Overview

Project Dragon - Sustainable Aviation Fuel (SAF) Production Facility (referred to as 'Project Dragon' throughout this document) is a proposed SAF production facility located in Port Talbot, Wales. The development includes enclosed ground flare, storage tanks, administration, warehouse and laboratory buildings as well as car parking/loading facilities. The development will be assessed against Approved Document B (ADB) Volume 2: Buildings other than dwellings, 2006 edition including 2010, 2013, 2016 and 2020 amendments – for use in Wales. PartB have reviewed the individual buildings located within the site plan for Building Regulations B1 - B4, and the site wide plan for B5.

Regulation B1 - Means of warning and escape

- The following purpose groups and travel distances are relevant to Project Dragon.
- The evacuation strategy will be simultaneous for all parts of the site
- In accordance with BS 5839-1:2017, the minimum fire detection and alarm system classification should be M (manual). PartB would suggest increasing this is to a minimum of L2/M for the smaller outbuildings. Insurer and Client requirements will need to be taken into account when designing the individual building and full site wide fire detection and alarm systems.

Purpose Group/s	Use of Premises	Maximum Travel distance (m)	
		Single direction	More than one direction
3	Office	18	45
6	Industrial – Normal Hazard	25	45
	Industrial – Higher Hazard	12	25
7	Storage – Normal Hazard	25	45
	Storage – Higher Hazard	12	25
2 – 7	Places of Special Fire Hazard	9	18
2 - 7	Plant (within room)	9	35
	Plant (internal escape route)	18	45
	Plant (open air escape route)	60	100

Regulation B2 - Internal Fire Spread (Linings)

- All wall and ceiling linings within the buildings should conform to Table 10 in ADB.
- All surface finishes and floor coverings materials should resist flame spread over their surfaces and, when ignited, any heat release or propagation of the fire is limited as recommended.

Regulation B3 - Internal Fire Spread (Structures)

- Elements of structure of the building should give 30 minutes for single storey buildings. Elements of structure for hazardous areas will be considered on an individual basis.
- No compartmentation is required within the individual buildings.

Regulation B4 - External Fire Spread

- The provisions for external fire spread will be calculated using the enclosing rectangle' method from BRE 187:2014 for the individual buildings.
- Due to the close proximity of the industrial equipment to each other and to the buildings and storage around the site, blast analysis will also be undertaken to review any blast resistance requirements for the walls of the buildings.


Regulation B5 - Access and Facilities for the Fire Service

- The Fire Service require access to 15% of the perimeter of all of the individual buildings on site, or reach all areas in the building with 45m from the location of the parked pump appliance.
- Fire Service provisions for the highly hazardous areas on site will be reviewed individually.
- There should be a fire hydrant located within 90m of the Fire Service access to all areas of the site.




Legend

- FD30 Fire Door
- FD30S Fire Door
- 30 minutes Fire Rated Construction
- 60 minutes Fire Rated Construction
- - - Travel Distance

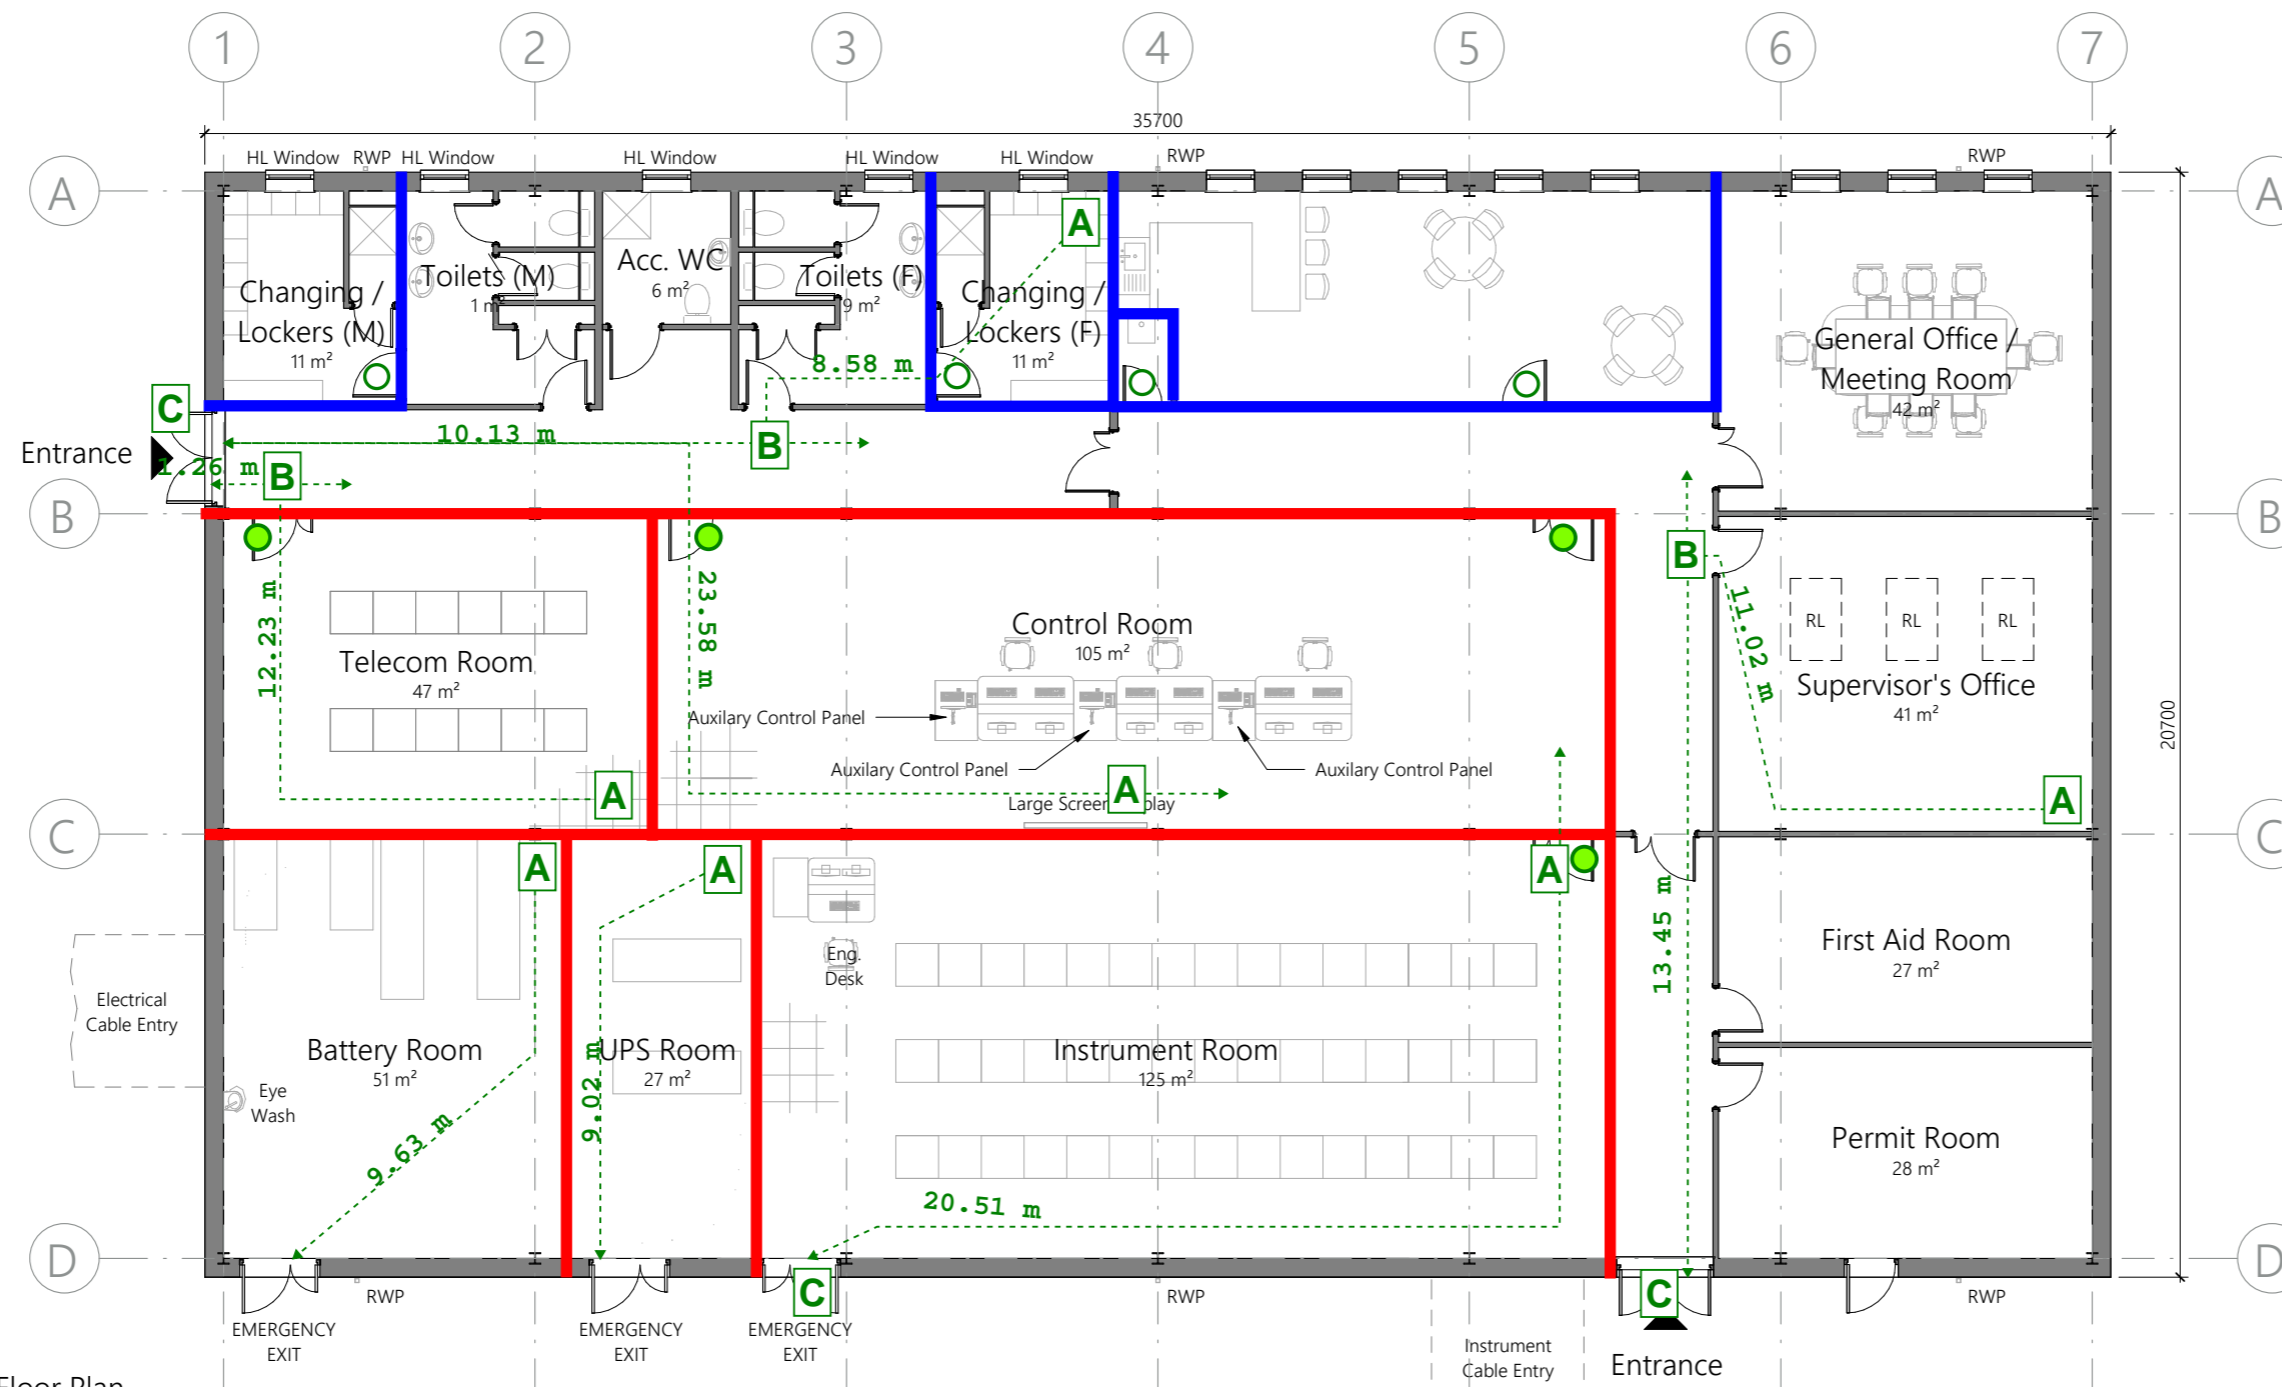

1 Proposed Ground Floor Plan
1:100

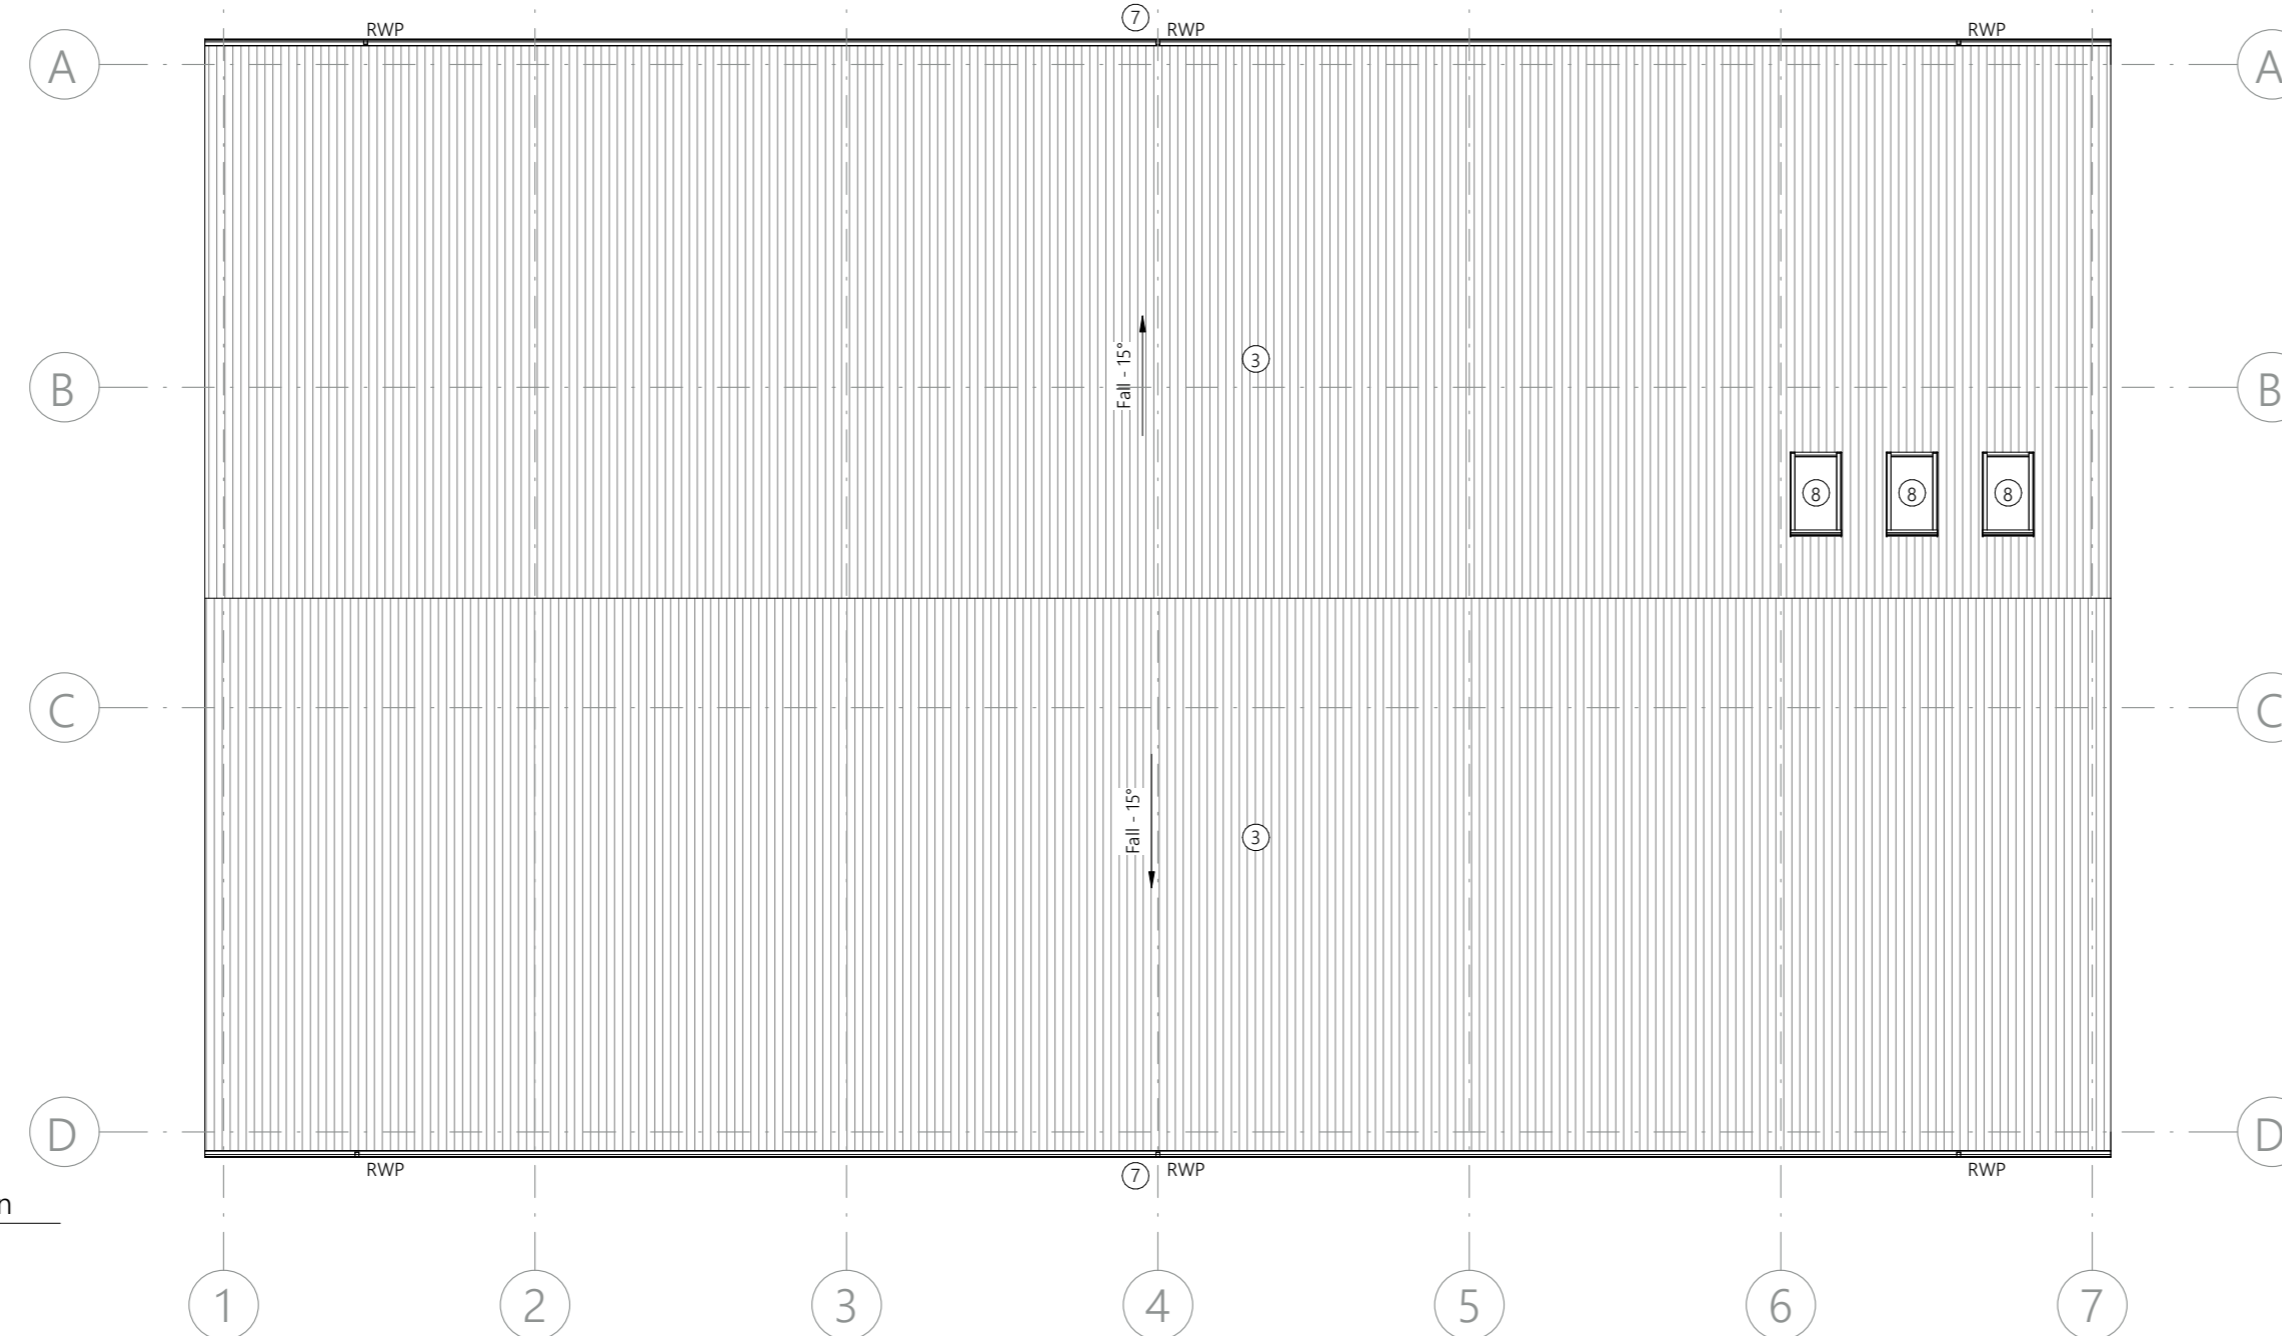


2 Proposed Roof Plan
1:100


Project Title		Project Dragon
Drawing Title		Process Control Building - Markups
Drawing Number		
Revision 00	Date 03.08.2023	PartB Group Pera Business Park Nottingham Road Melton Mowbray LE13 0PB
Drawn by Jessica Price		
Reviewed by Jon Preston		
PART B		

Legend

- FD30 Fire Door
- 30 minutes Fire Rated Construction
- - - Travel Distance

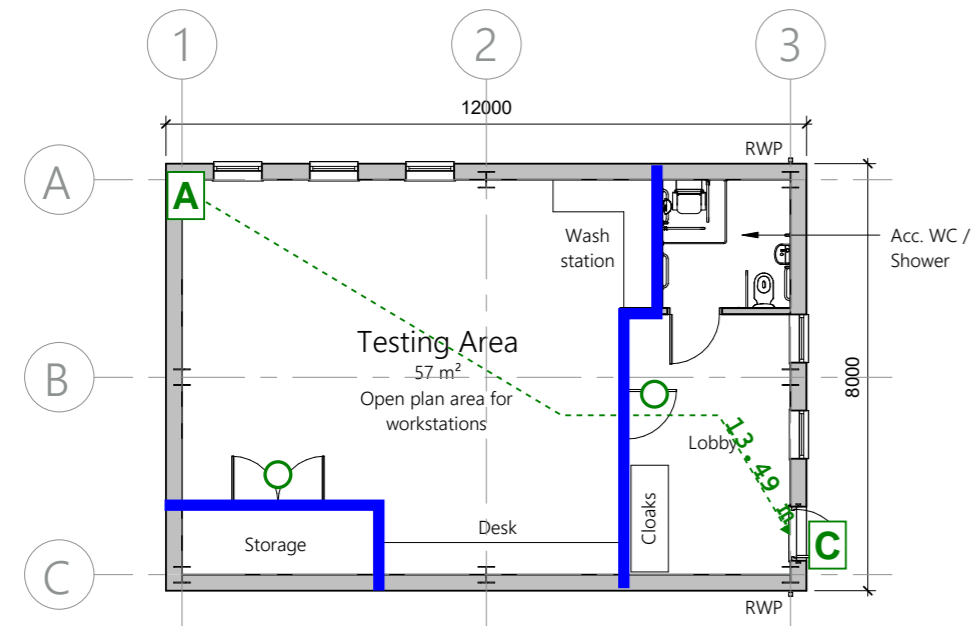


1 Proposed Ground Floor Plan
1:100

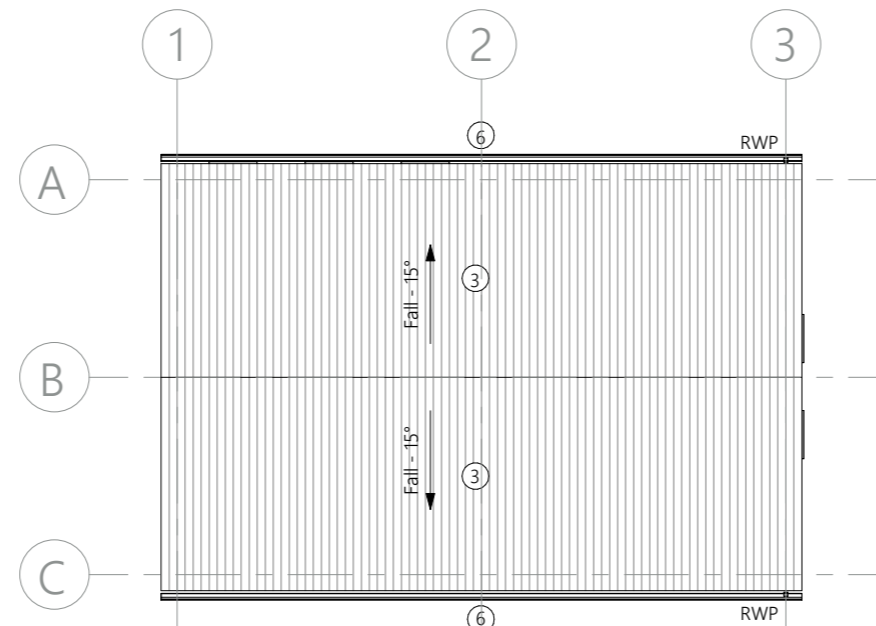


2 Proposed Roof Plan
1:100




7 Laboratory 3D View 1

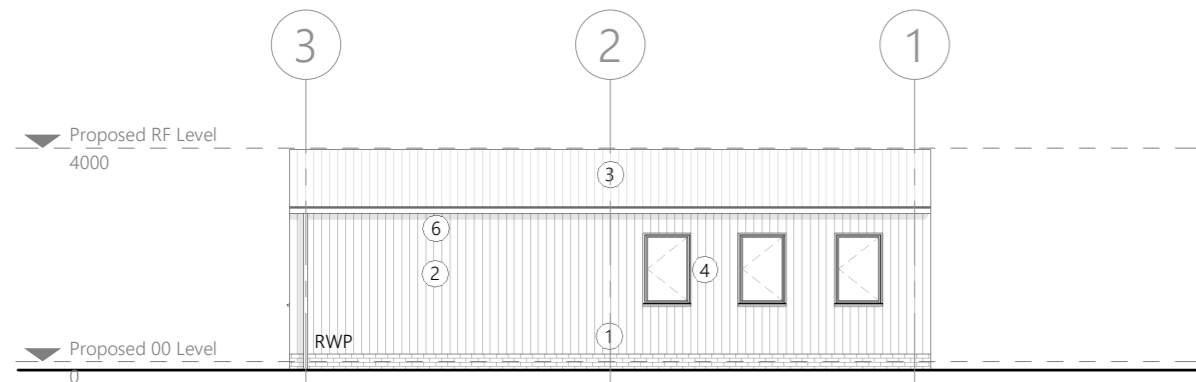


3 Proposed North Elevation
1:100

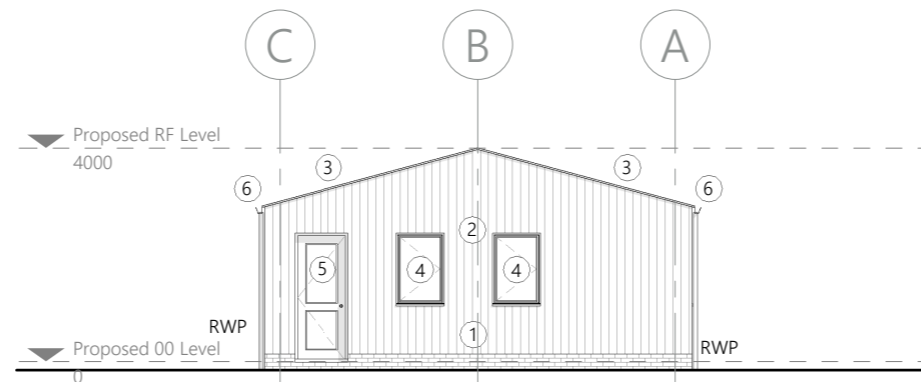

4 Proposed East Elevation
1:100

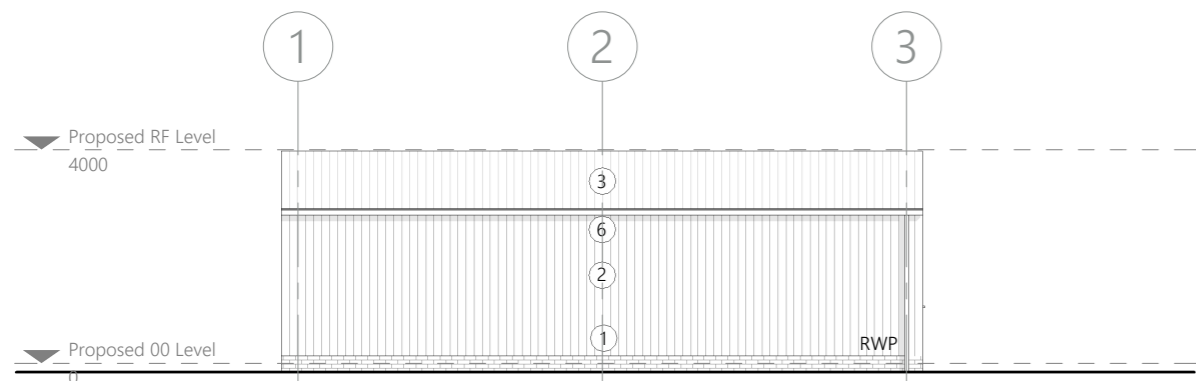


5 Proposed South Elevation
1:100

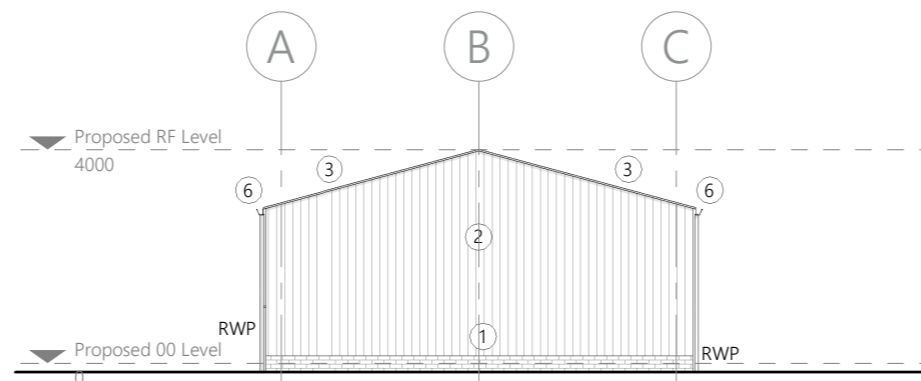

6 Proposed West Elevation
1:100

Project Information		
Project Title	Project Dragon	
Drawing Title	Laboratory - Markups	
Drawing Number		
Revision 00	Date 03.08.2023	PartB Group Pera Business Park Nottingham Road Melton Mowbray LE13 0PB
Drawn by	Jessica Price	
Reviewed by	Jon Preston	
PART B		

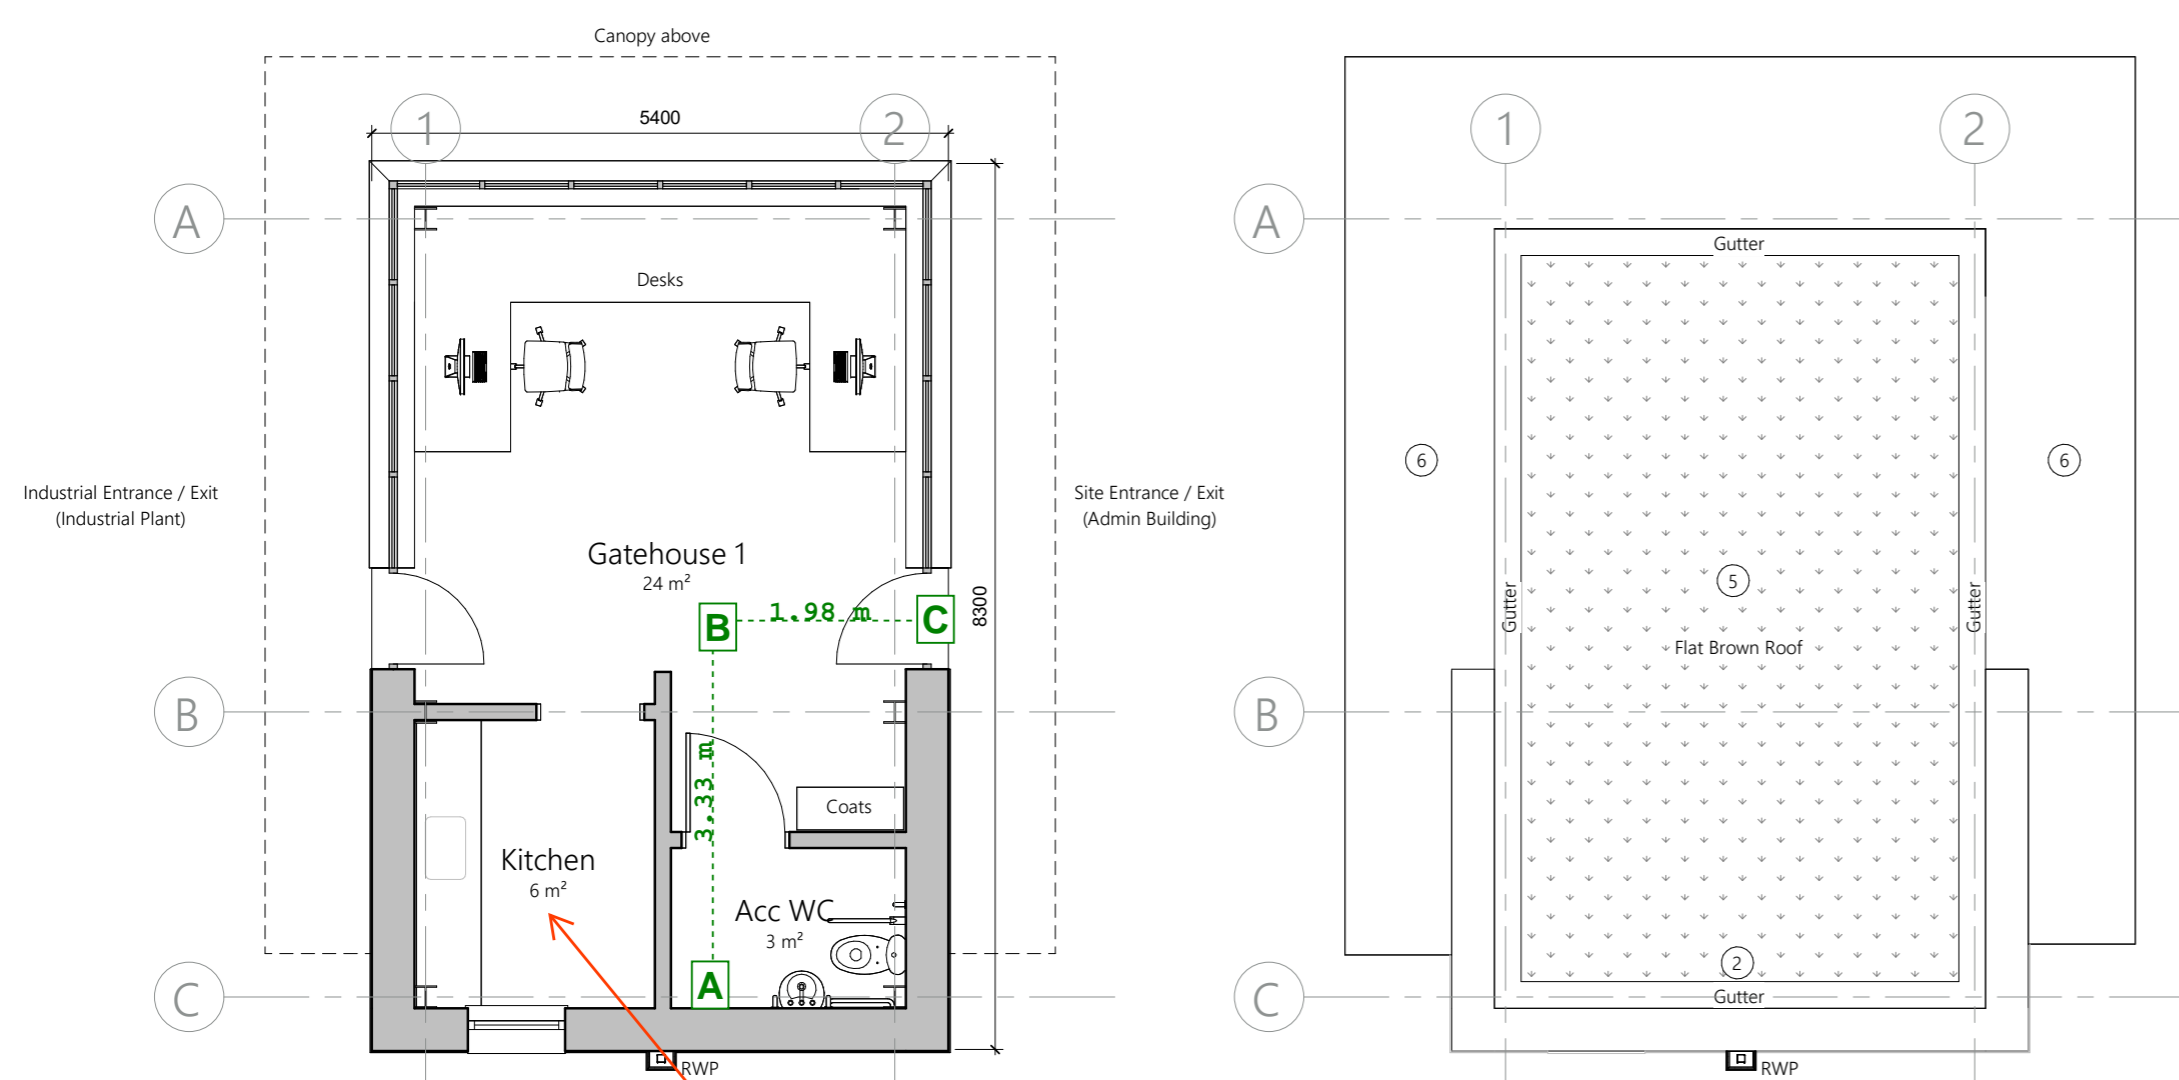


7 Gatehouse 3D View 1


1 Proposed Ground Floor Plan
1:50

2 Proposed Roof Plan


PartB Fire Safety Design Comment
 Kitchen contains cold food prep and re-heat (microwave) only, therefore is not considered a hazard room.

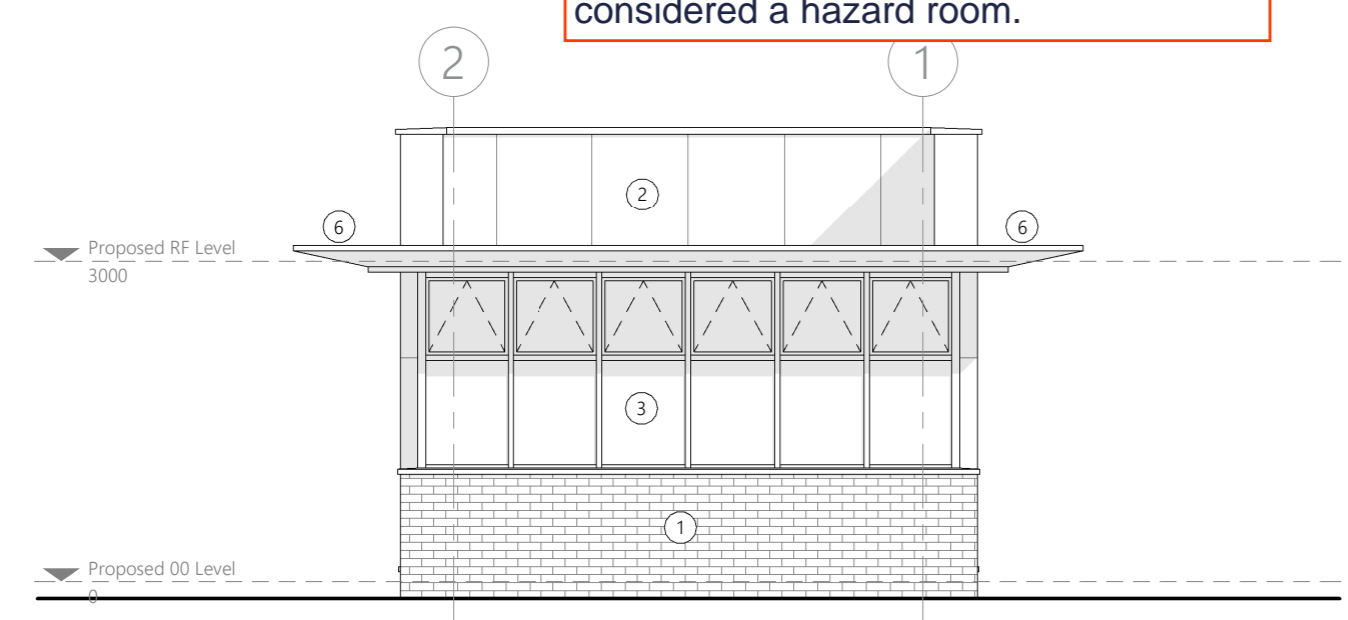


3 Proposed North Elevation
1:50

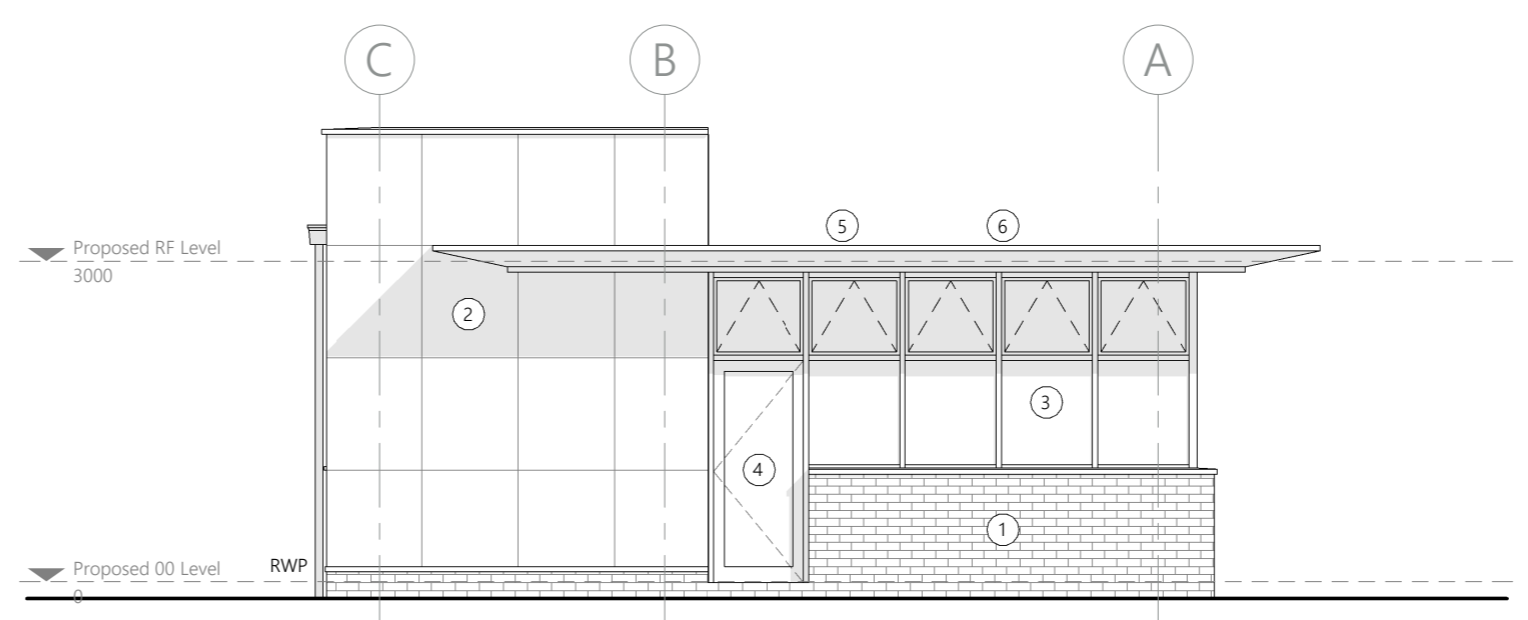

4 Proposed East Elevation
1:50

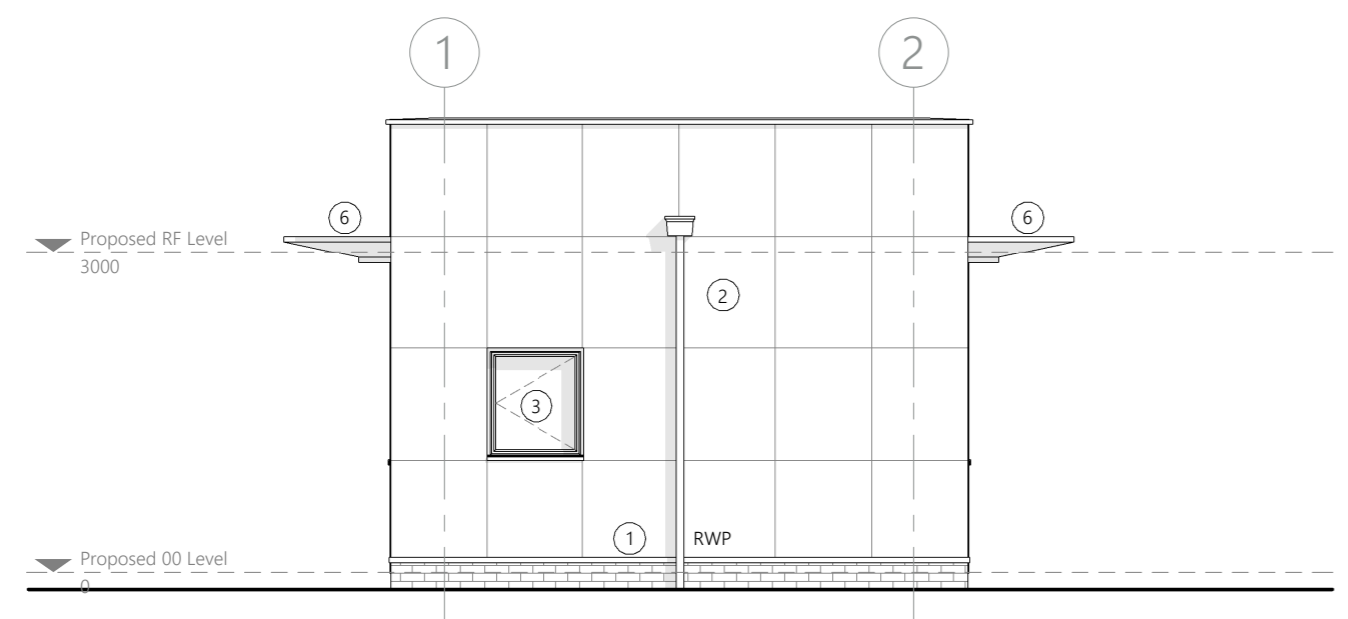

5 Proposed South Elevation
1:50

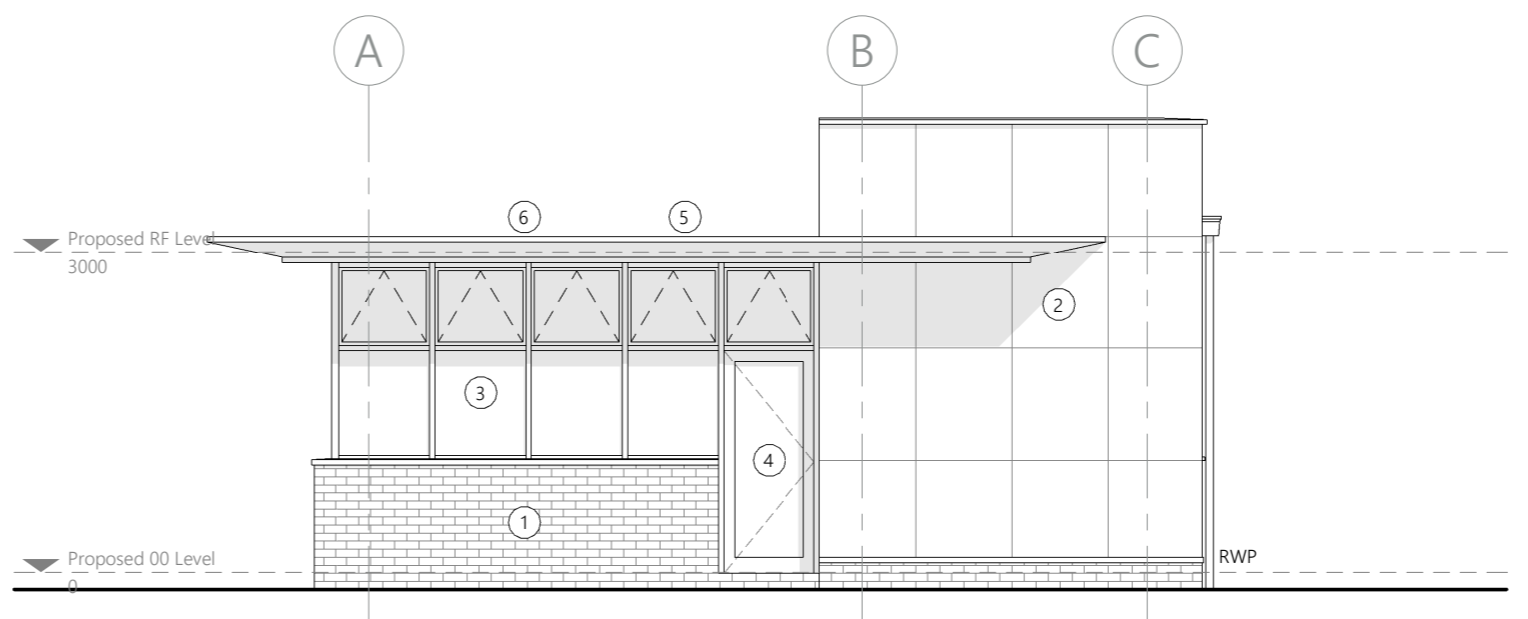


6 Proposed West Elevation
1:50

PART B	
Project Title	Project Dragon
Drawing Title	Gatehouse 1 - Markups
Drawing Number	
Revision 00	Date 03.08.2023
Drawn by	Jessica Price
Reviewed by	Jon Preston
PartB Group Pera Business Park Nottingham Road Melton Mowbray LE13 0PB	

Legend

Travel Distance

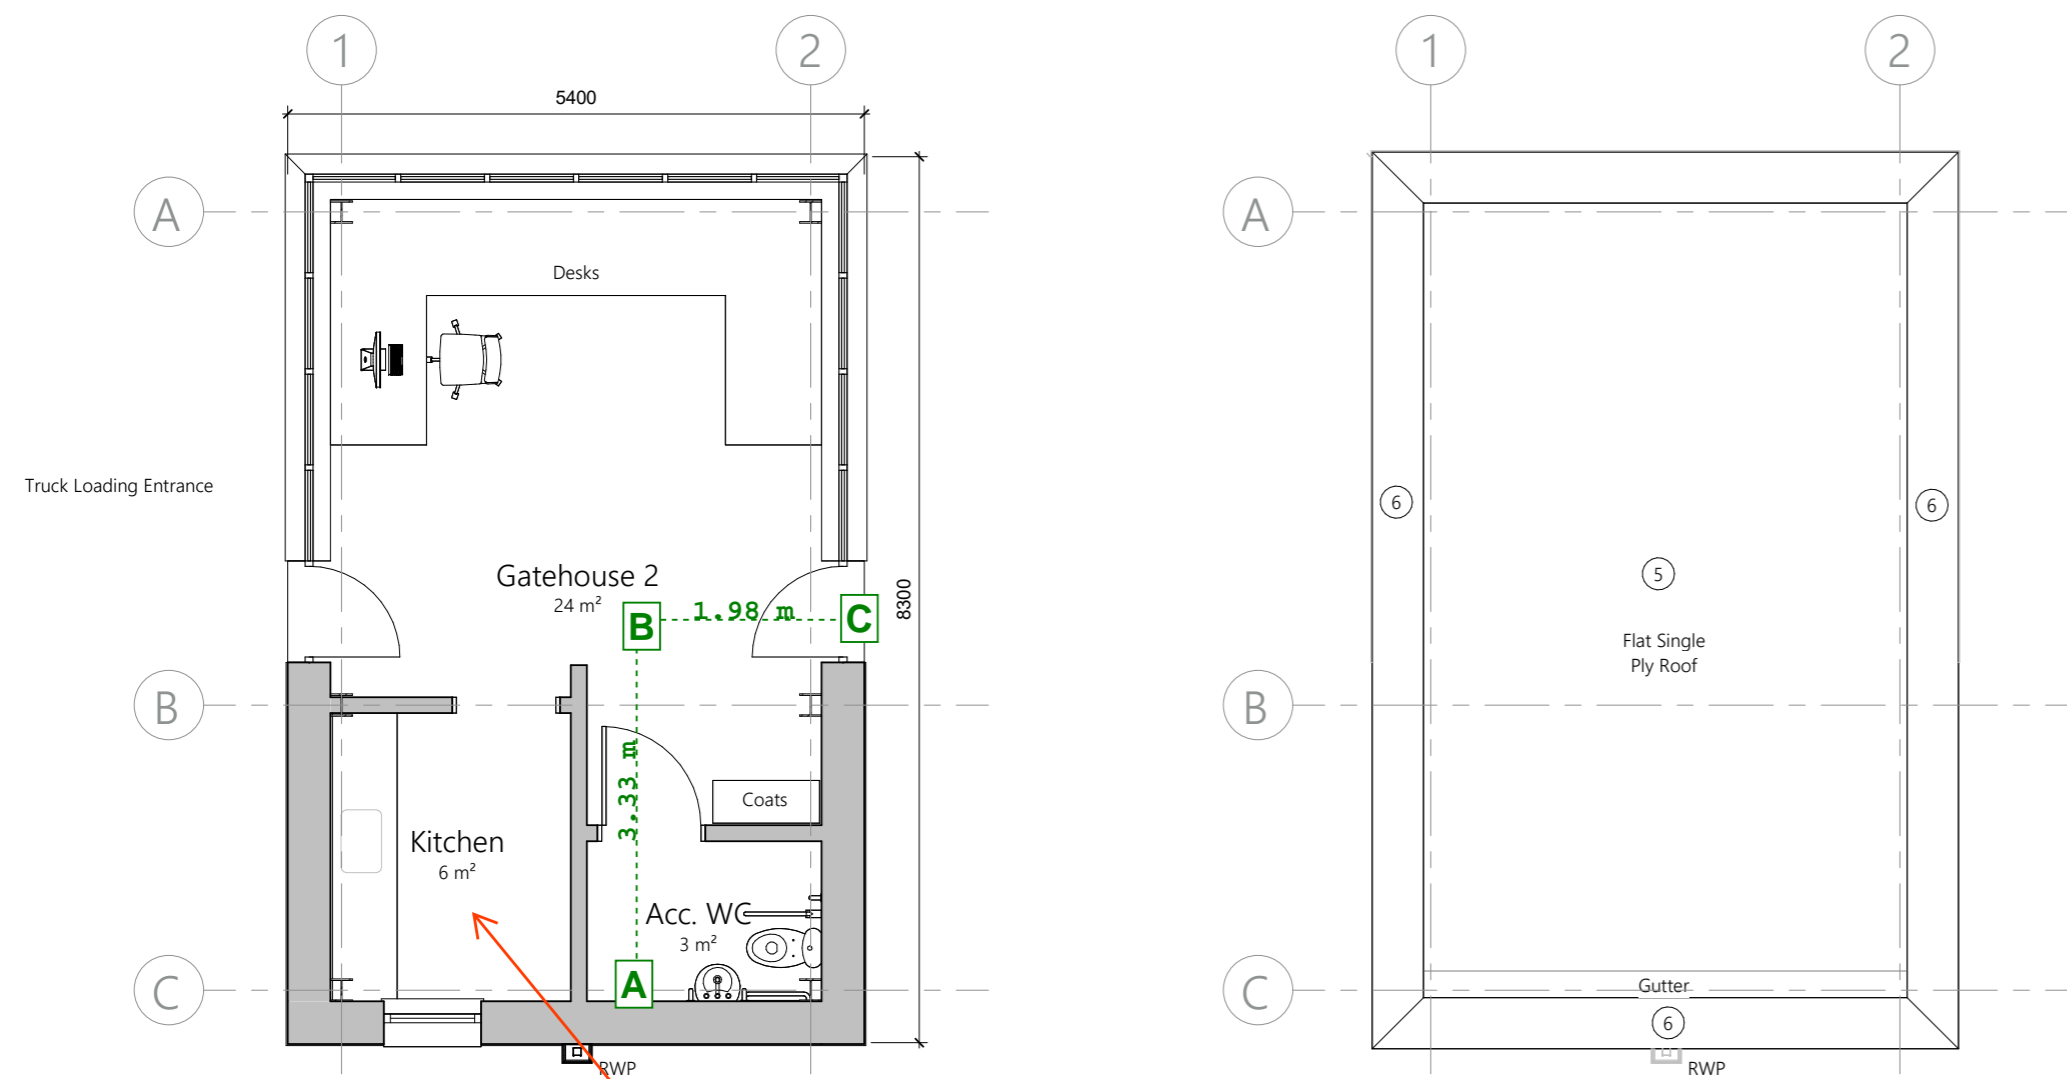


7 Gatehouse 2 3D View 1


1 Proposed Ground Floor Plan
1:50

Proposed Roof Plan


Part B Fire Safety Design Comment
Kitchen contains cold food prep and re-heat (microwave) only, therefore is not considered a hazard room.

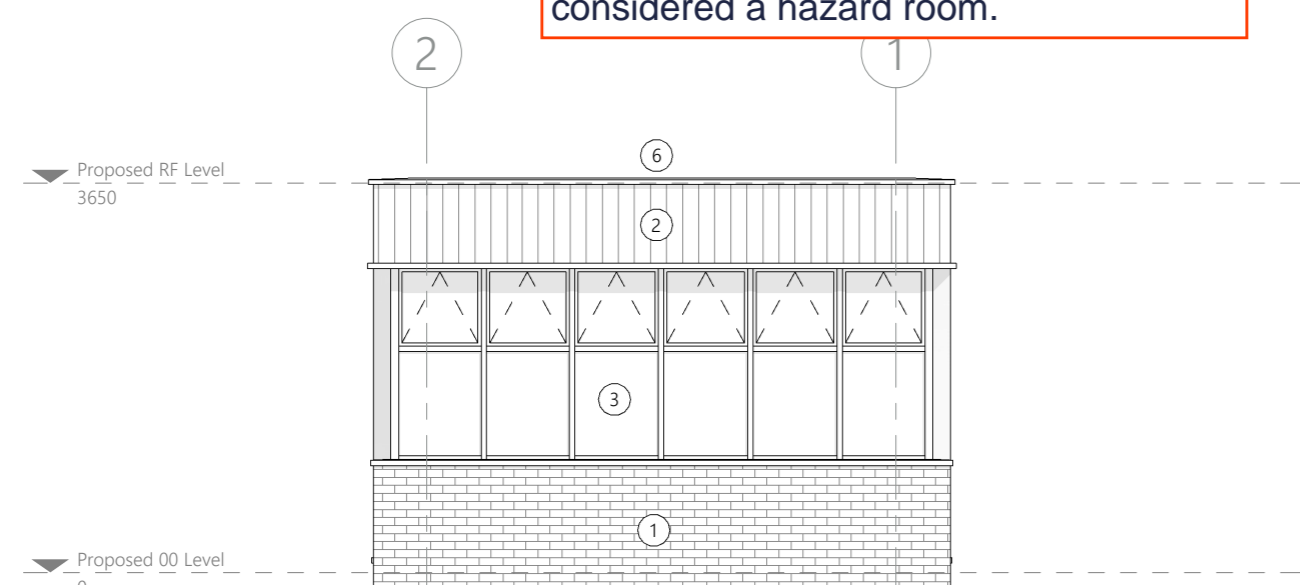


3 Proposed South Elevation
1:50

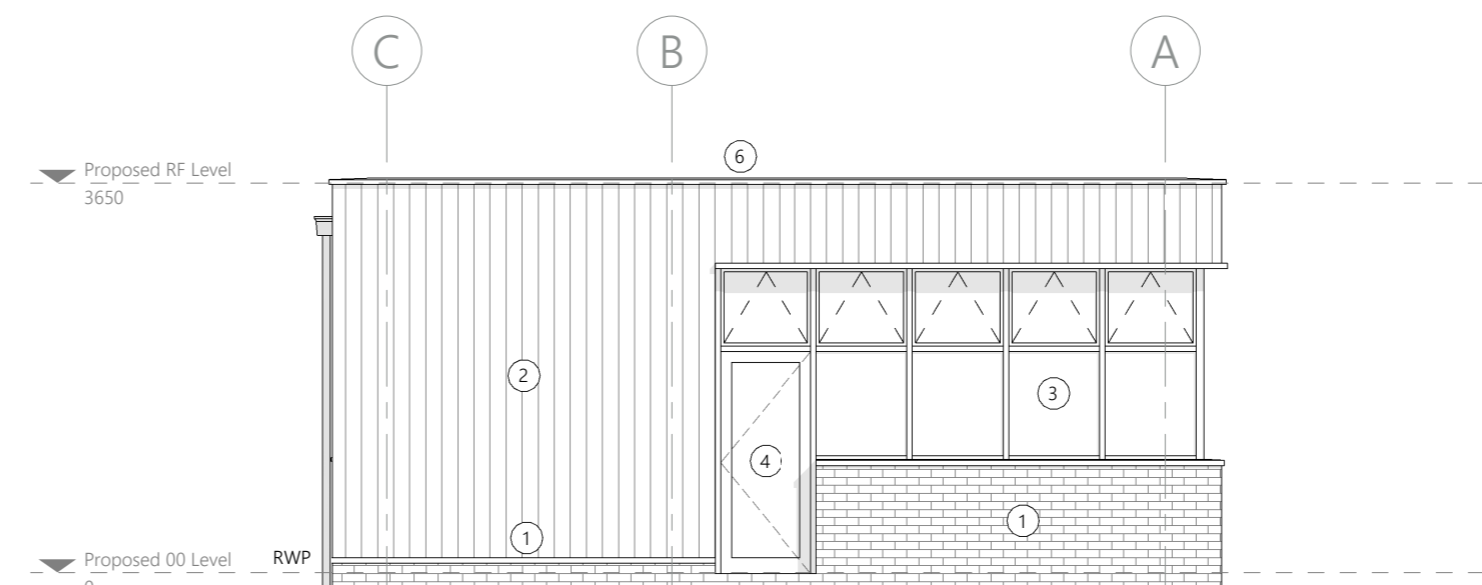

4 Proposed West Elevation
1:50

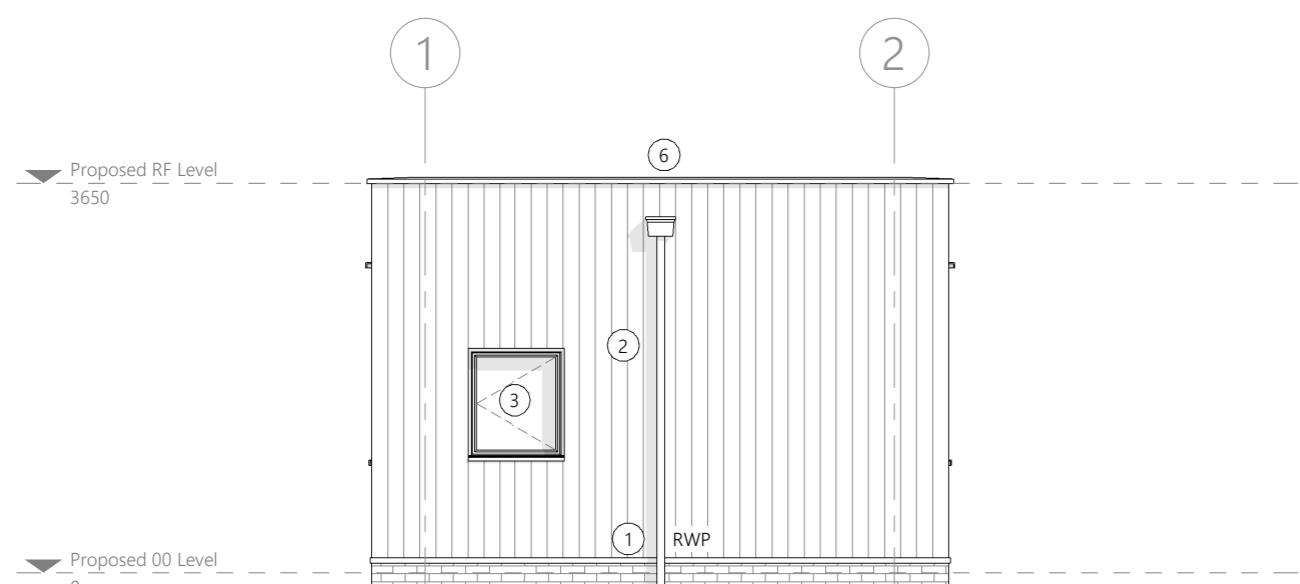

5 Proposed North Elevation
1:50

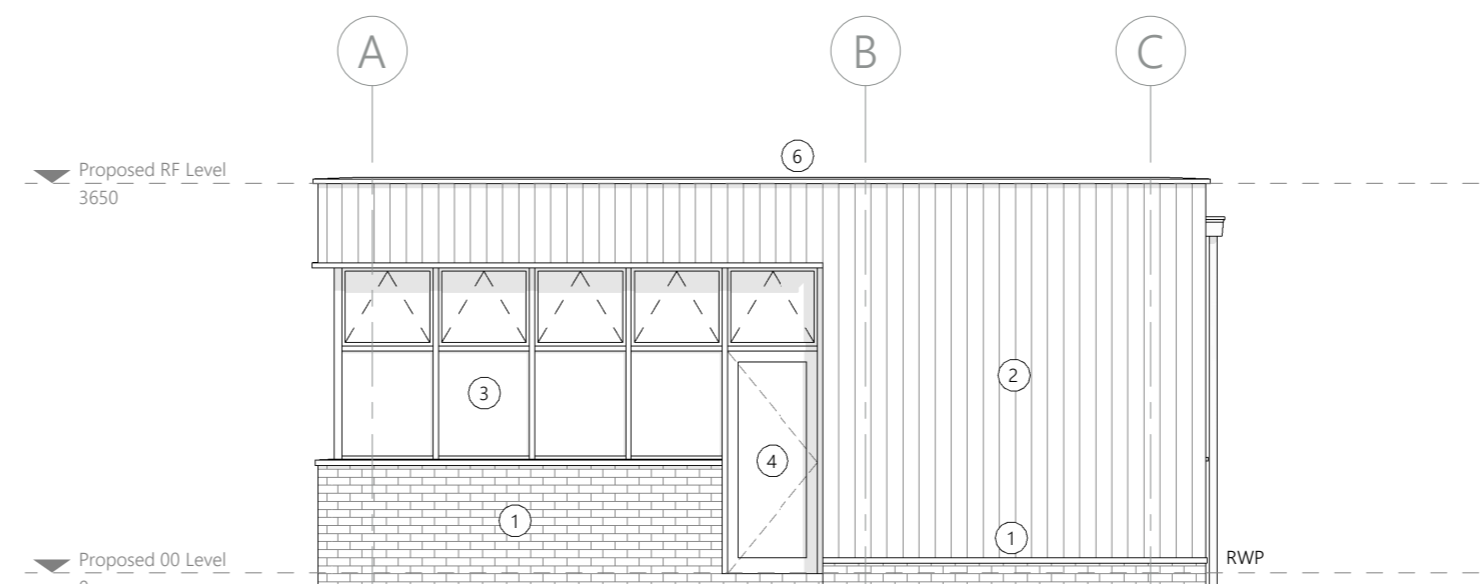


6 Proposed East Elevation
1:50

Project Title		Project Dragon
Drawing Title		Gatehouse 2 - Markups
Drawing Number		
Revision 00	Date	03.08.2023
Drawn by	Jessica Price	PartB Group Pera Business Park Nottingham Road Melton Mowbray LE13 0PB
Reviewed by	Jon Preston	




Legend


- FD30 Fire Door
- 30 minutes Fire Rated Construction
- Travel Distance

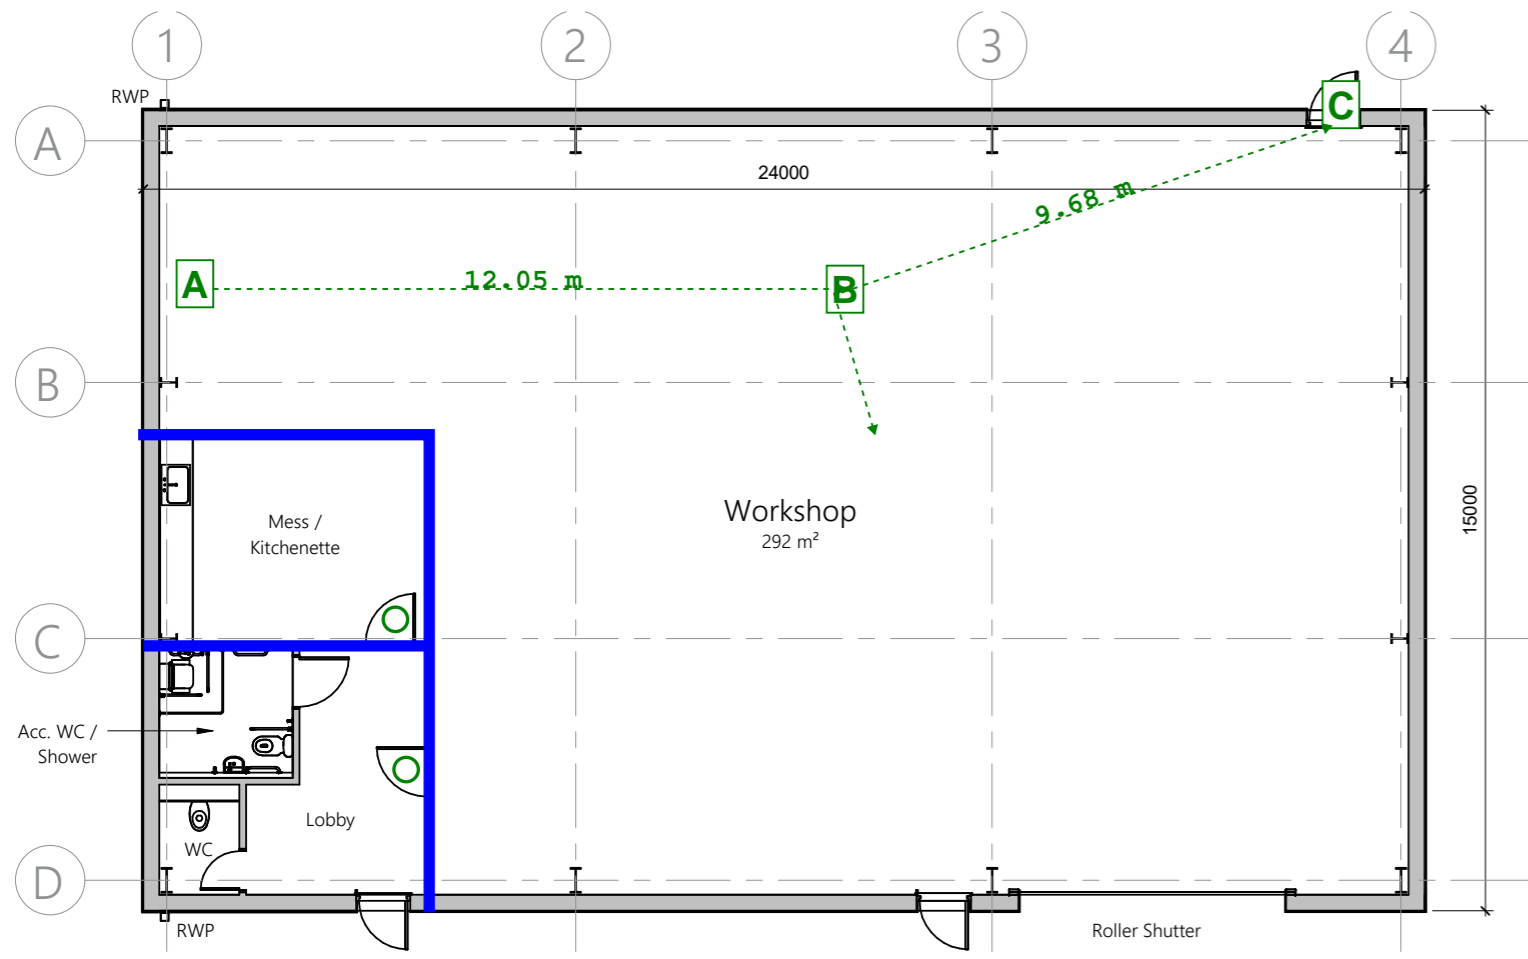


1 Proposed Ground Floor Plan
1:100

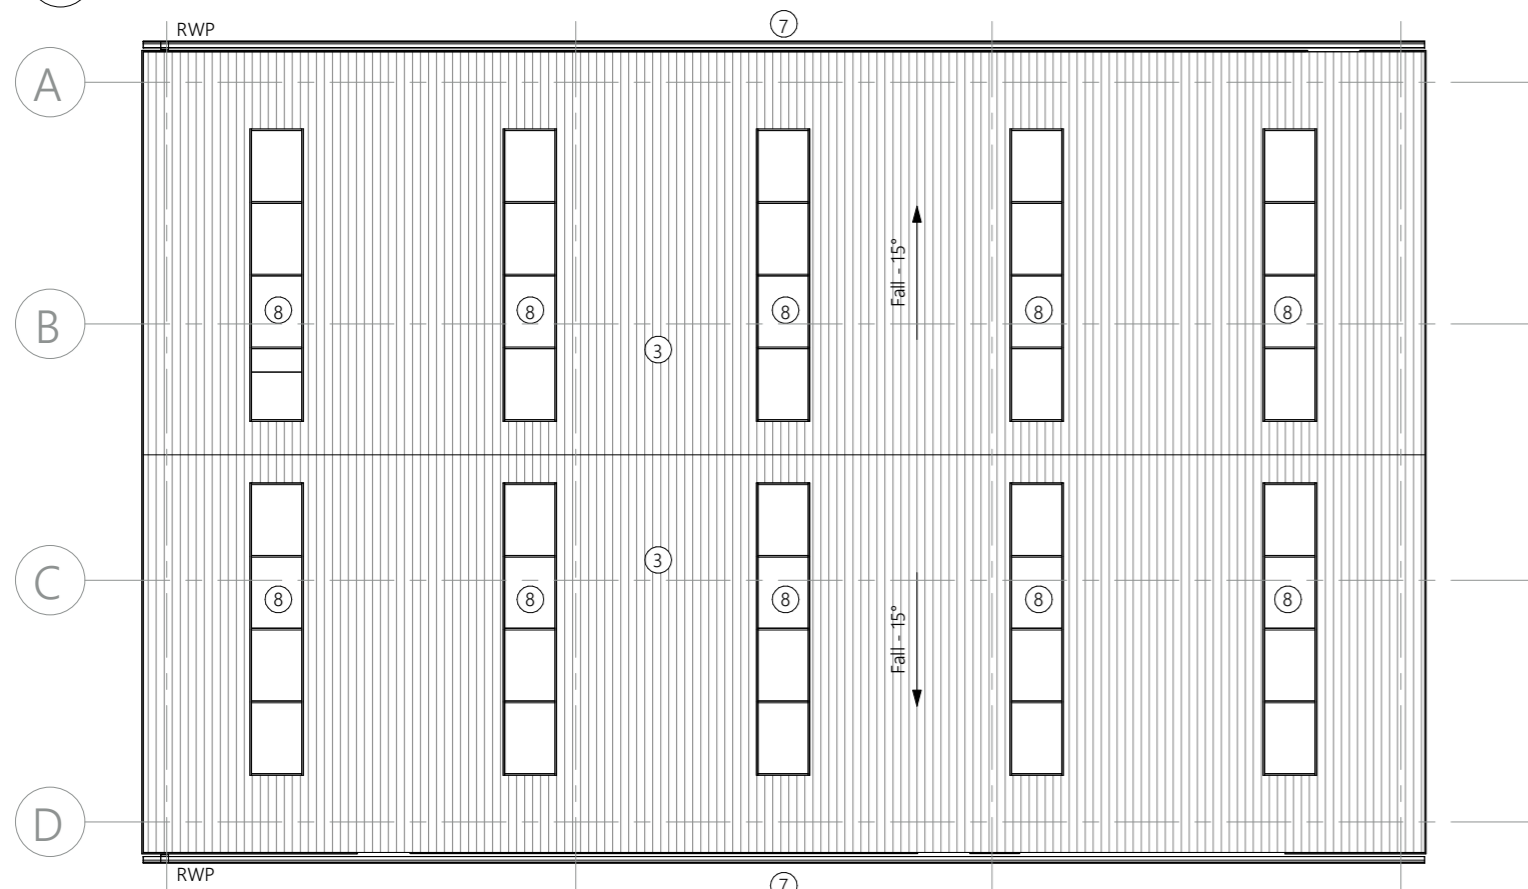


2 Proposed Roof Plan
1:100

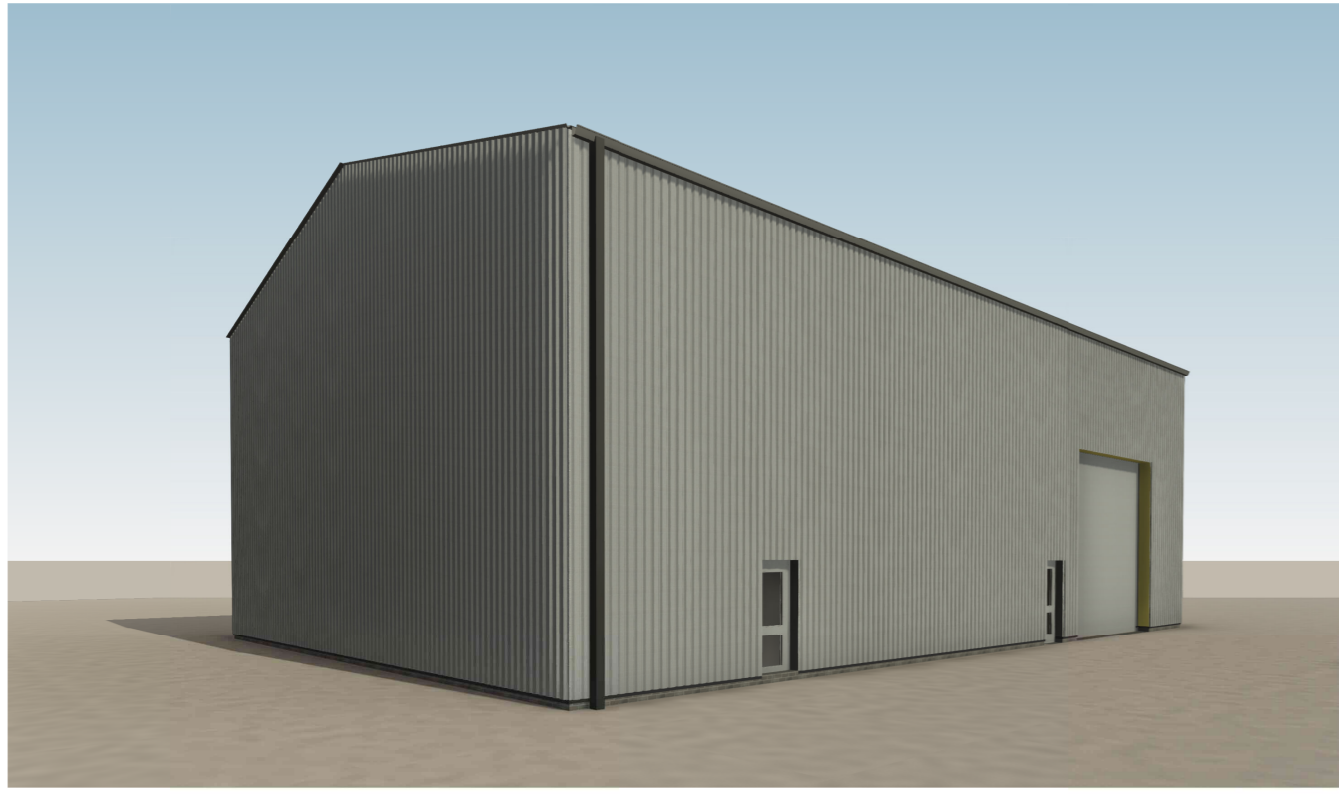


7 Workshop 3D View 1

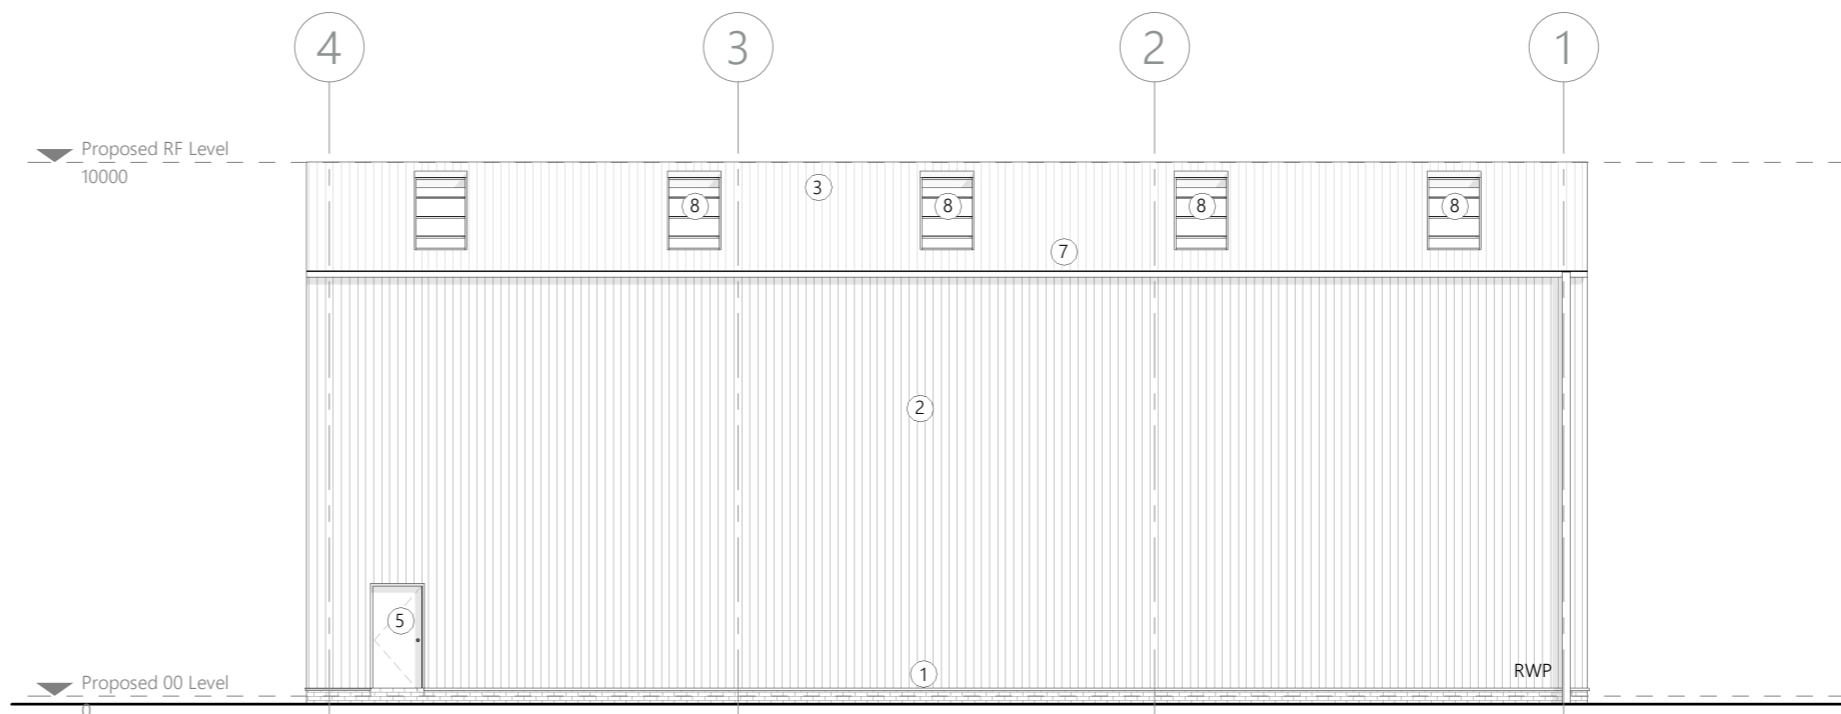

3 Proposed East Elevation
1:100

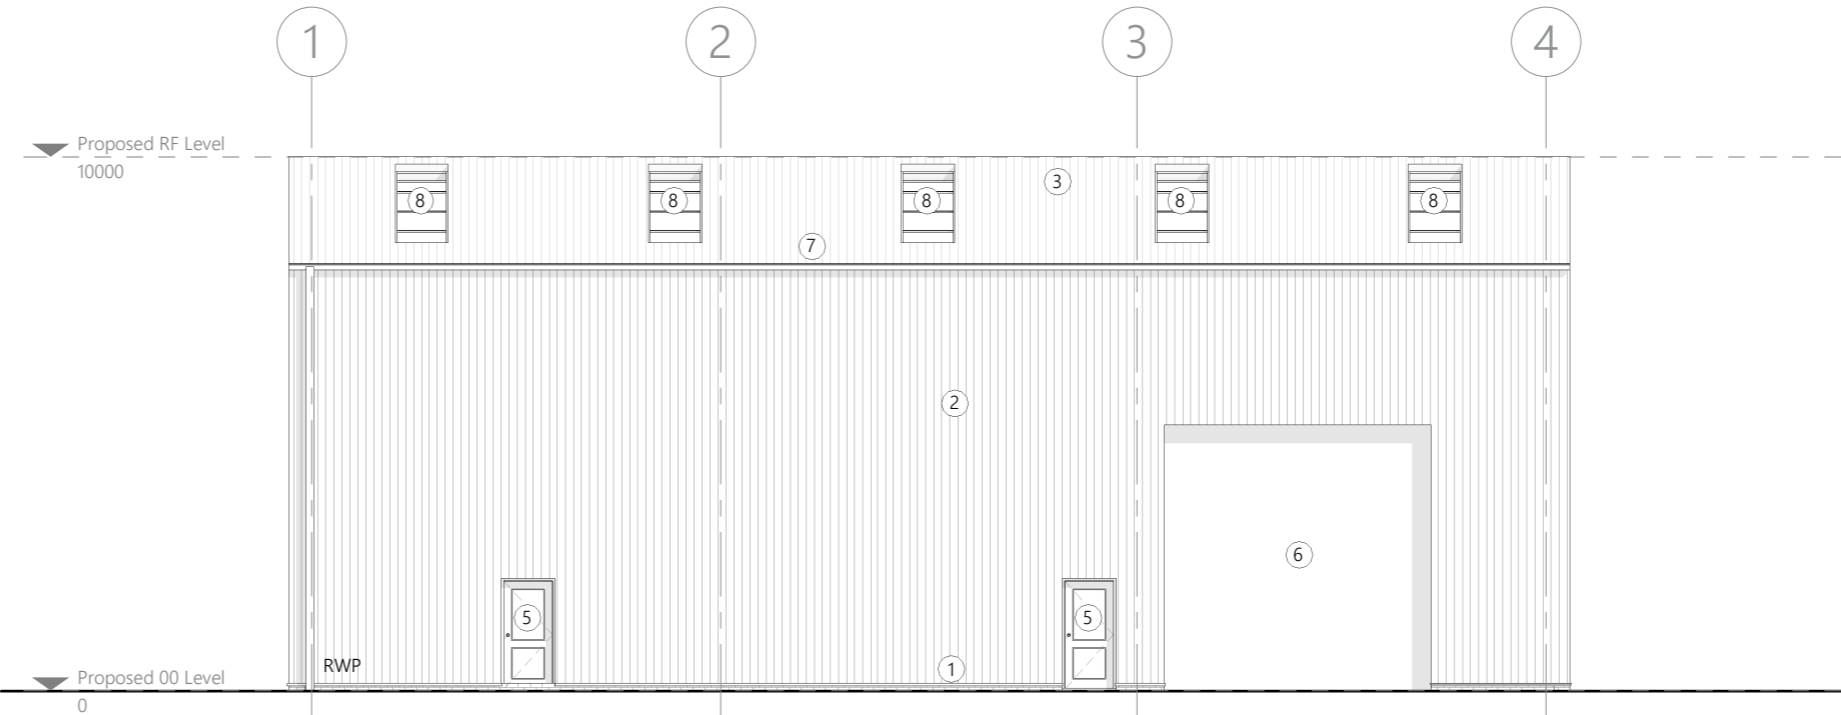

4 Proposed West Elevation
1:100

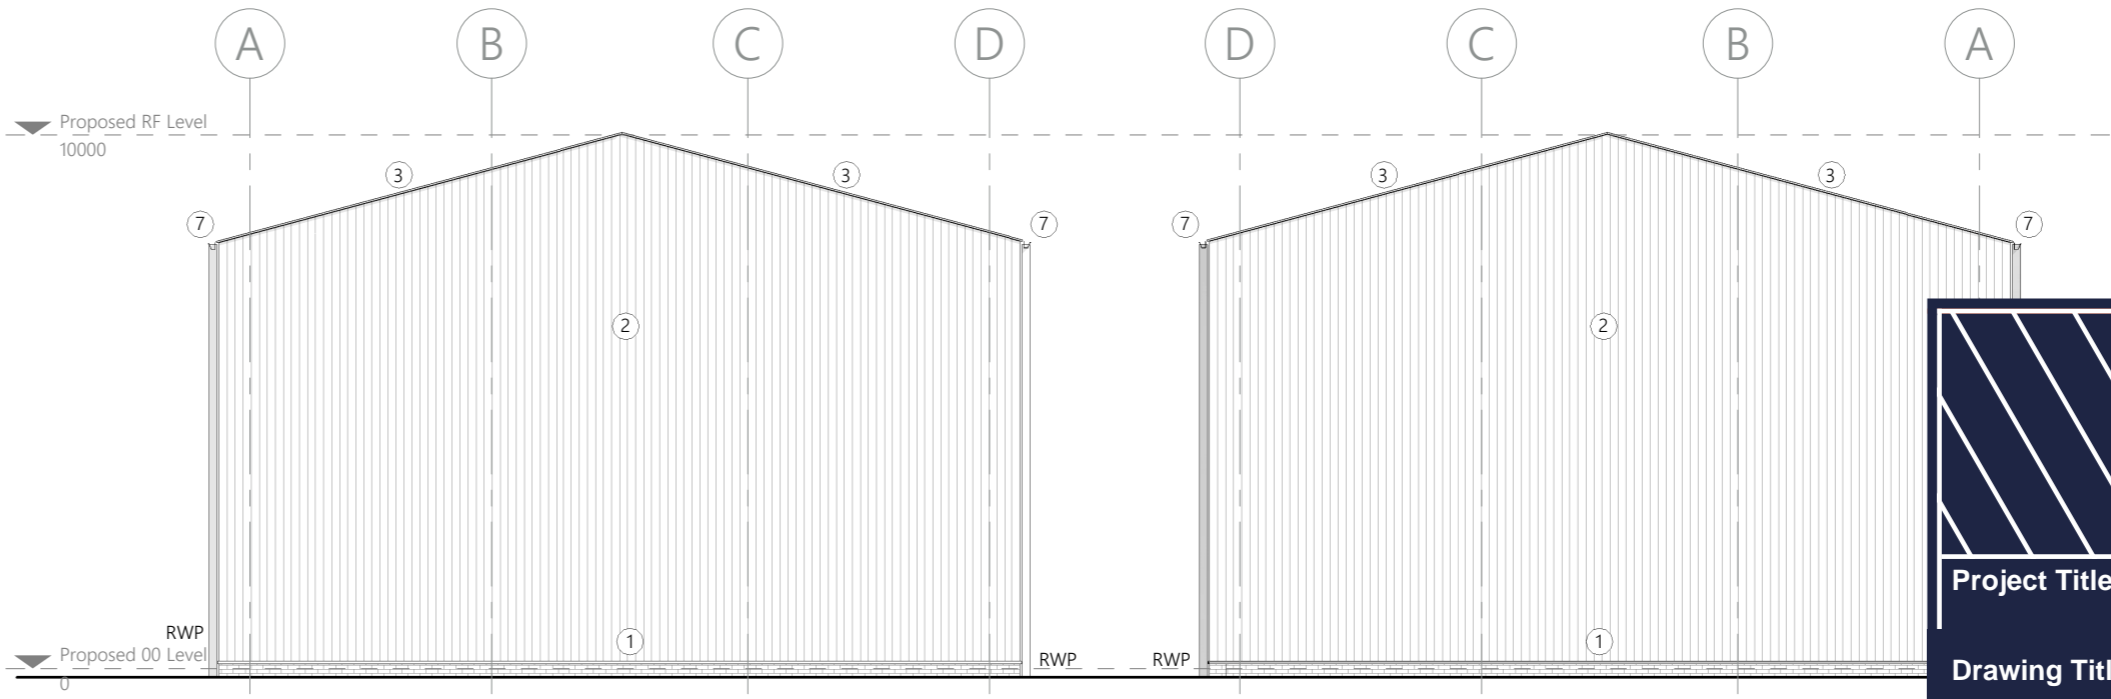



5 Proposed South Elevation
1:100

6 Proposed North Elevation
1:100


Project Title		Project Dragon
Drawing Title		Workshop - Markups
Drawing Number		
Revision 00	Date	03.08.2023
Drawn by	Jessica Price	
Reviewed by	Jon Preston	
		PartB Group Pera Business Park Nottingham Road Melton Mowbray LE13 0PB
		PART B

Legend



Travel Distance

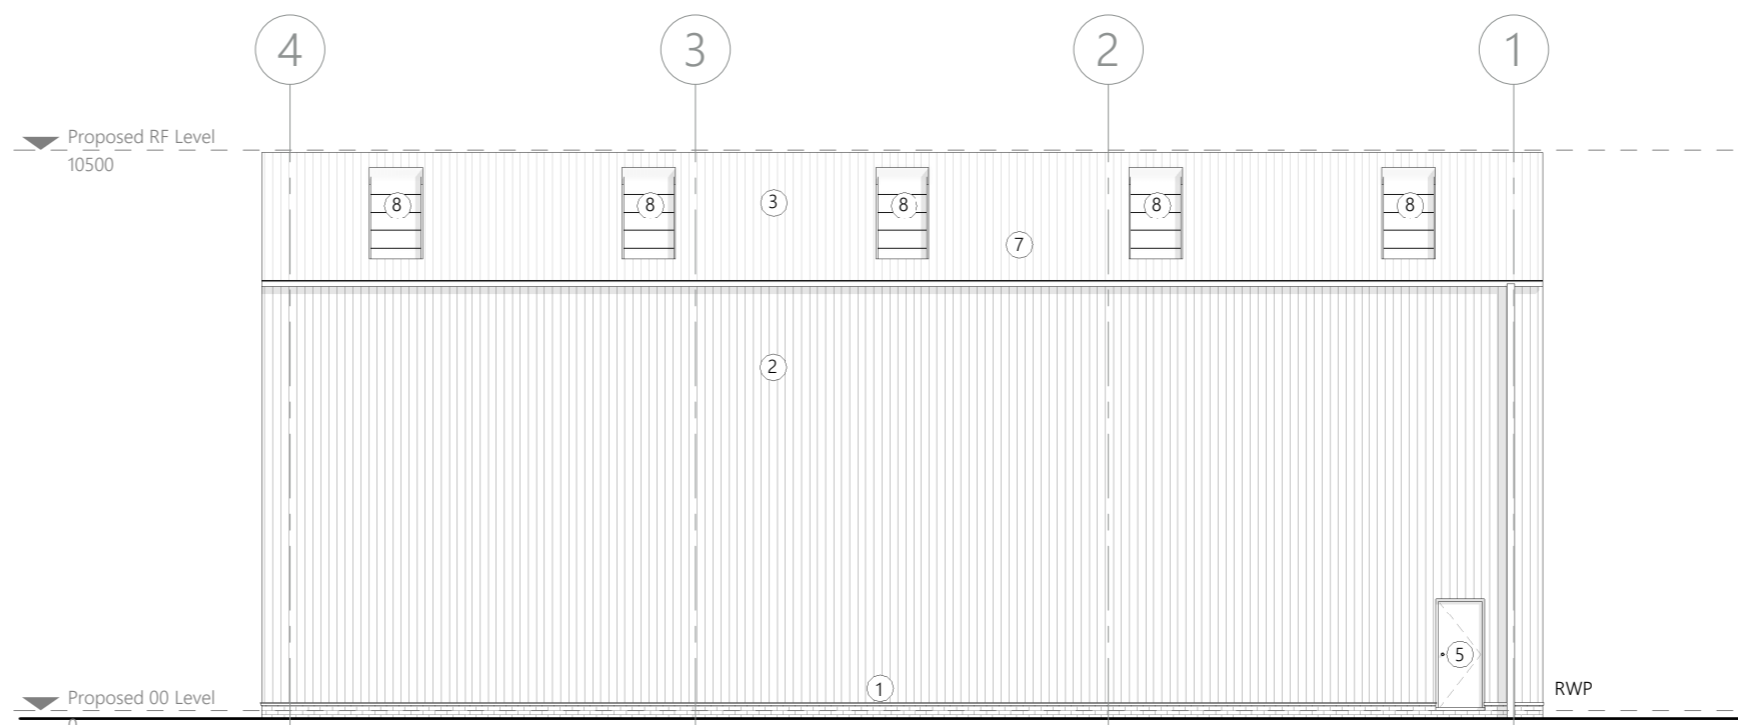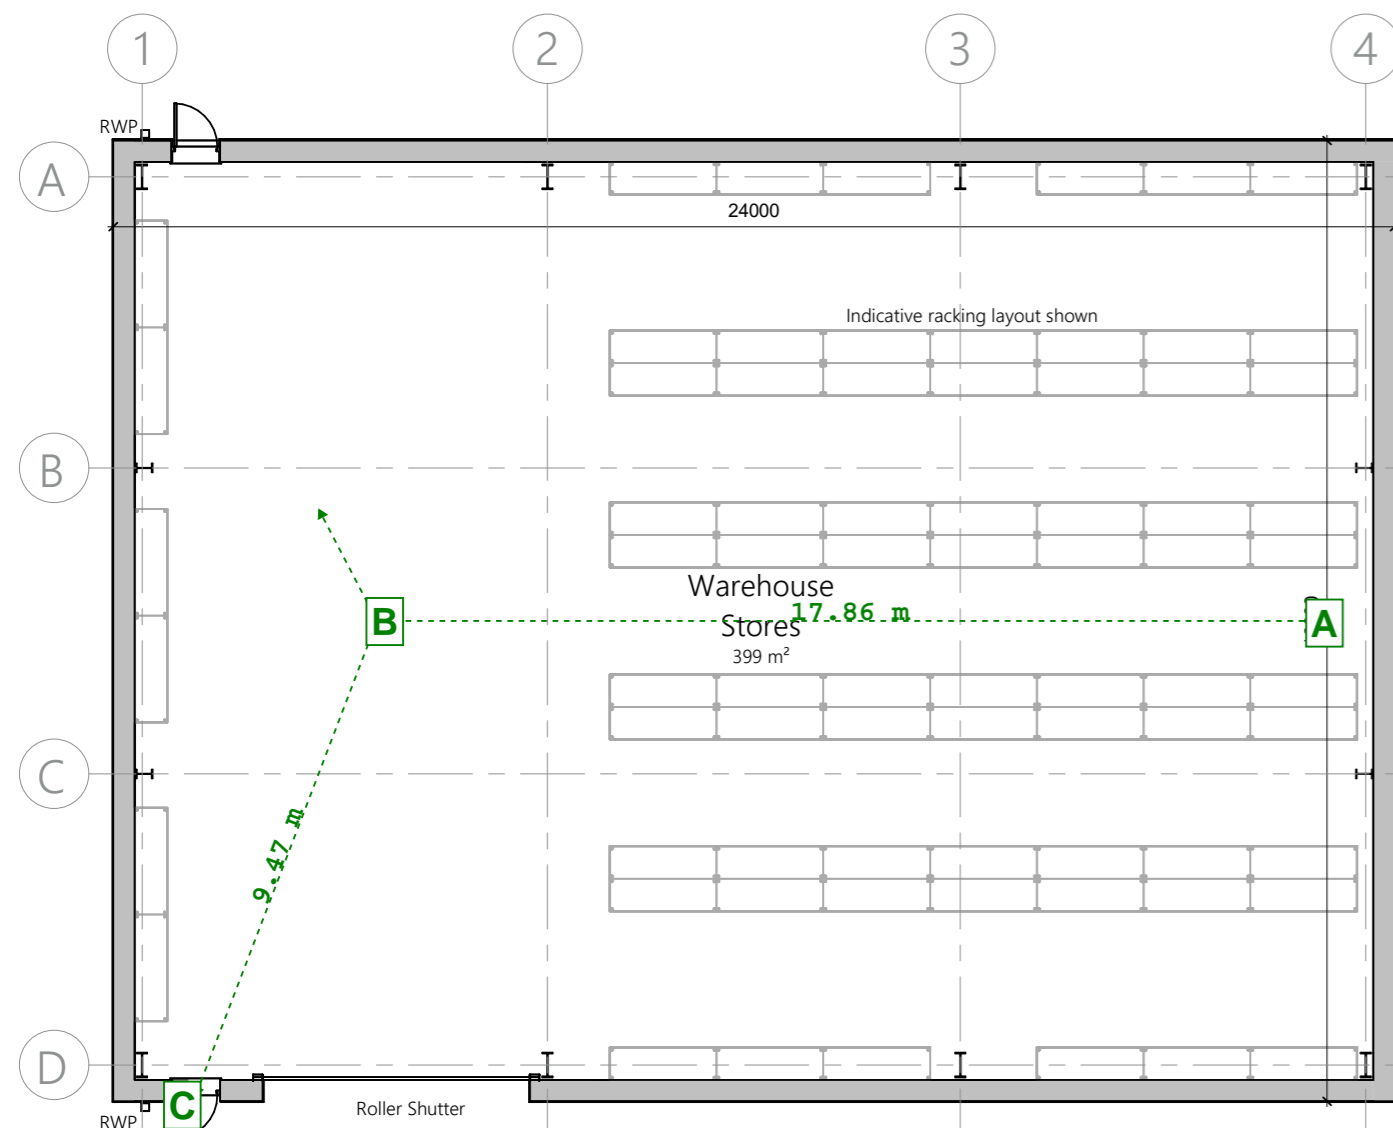

3 Proposed East1 Elevation
1:100

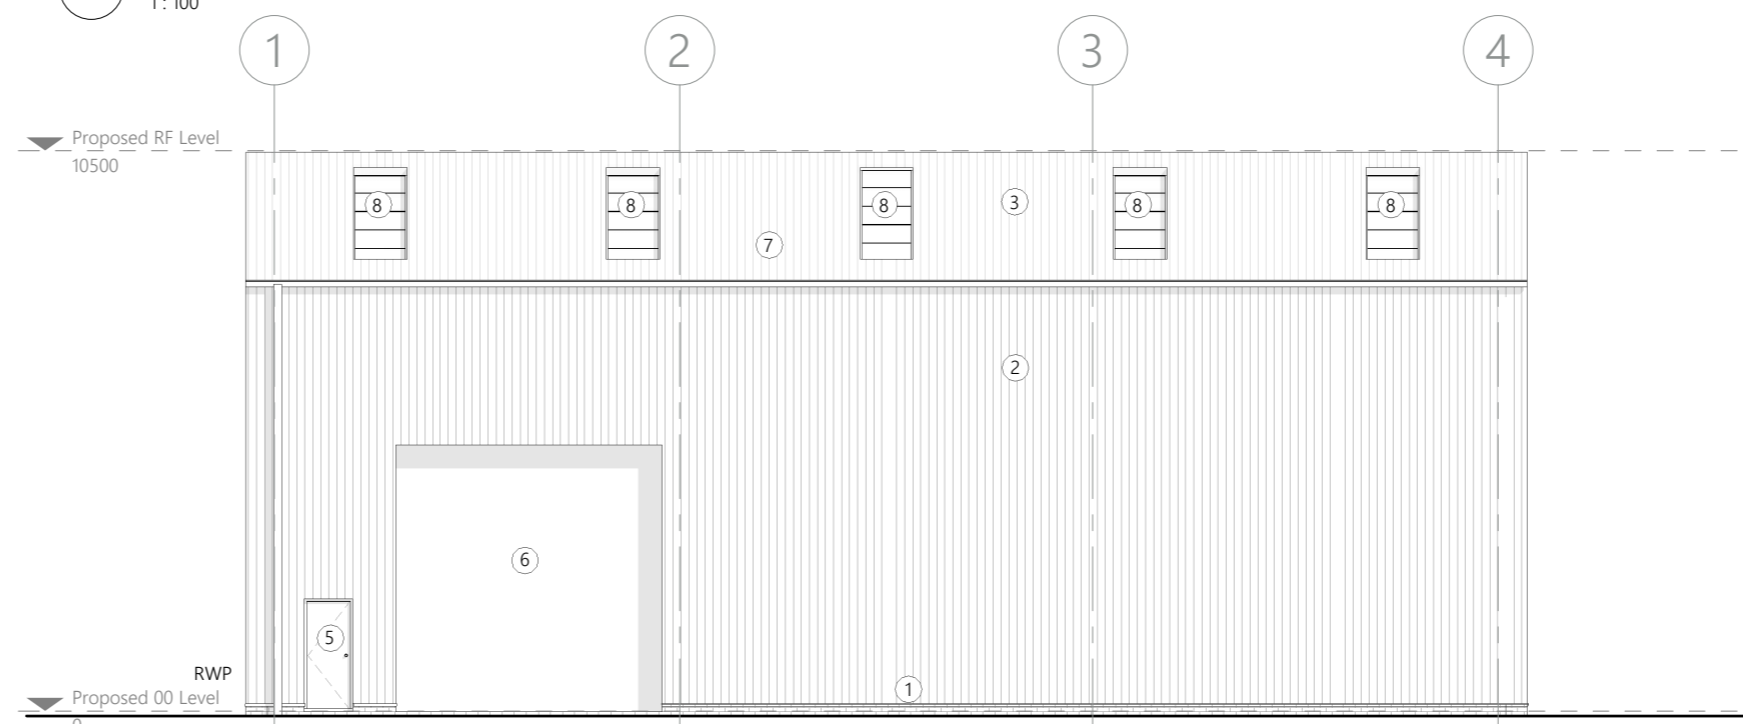

4 Proposed West1 Elevation
1:100

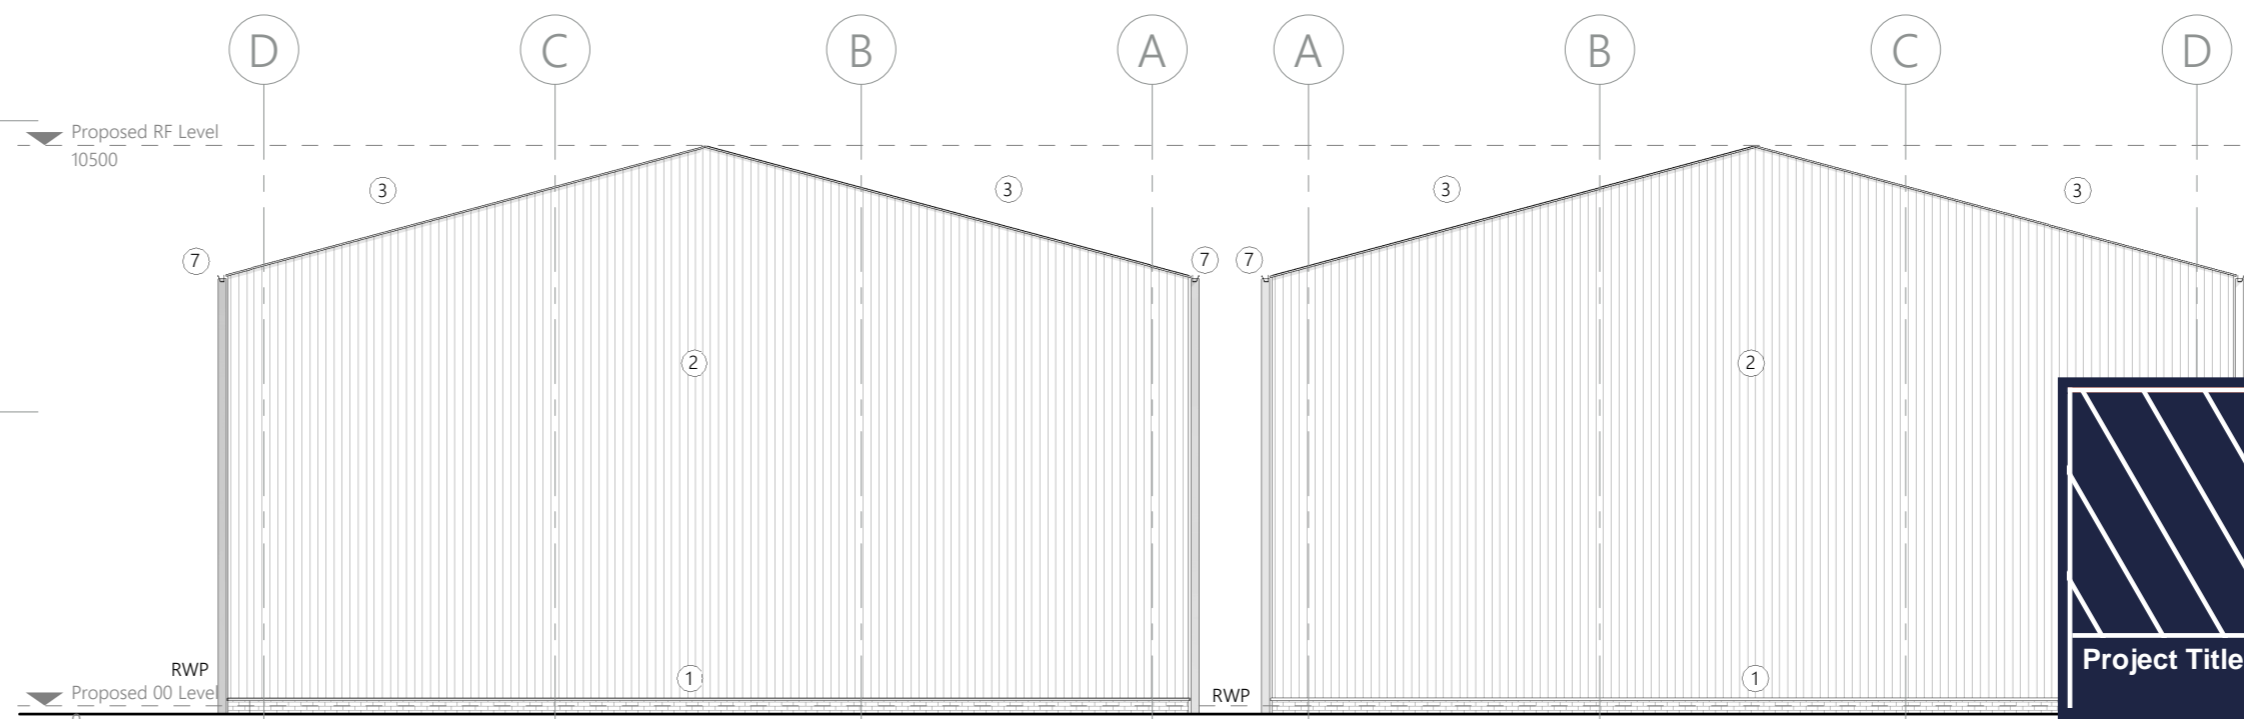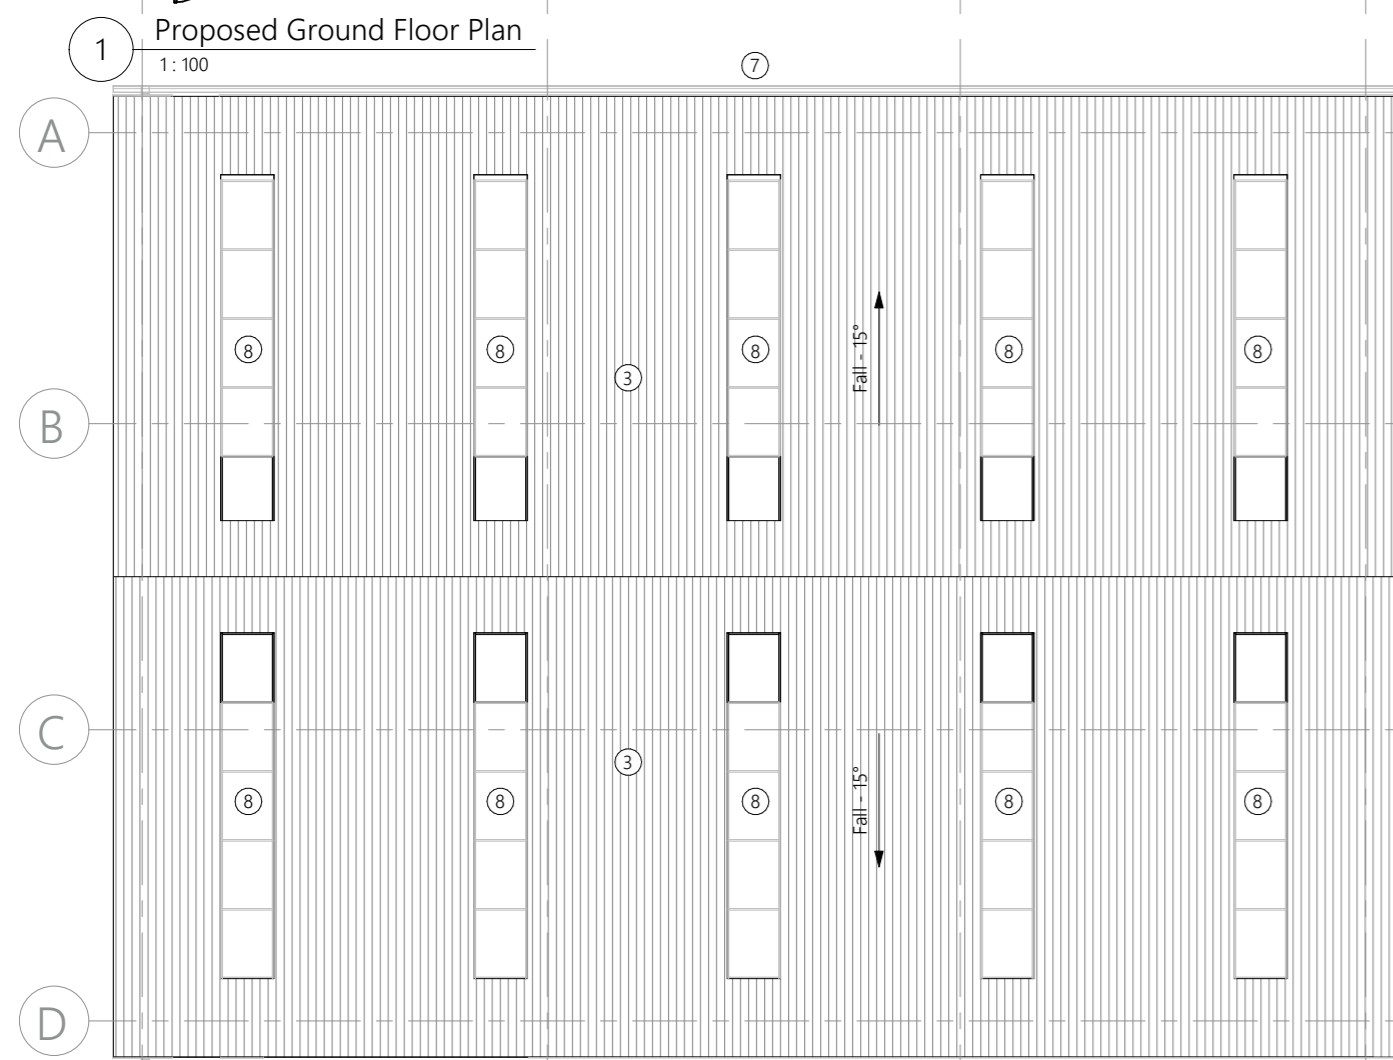


5 Proposed East Elevation
1:100

6 Proposed West Elevation
1:100




7 Warehouse 3D View 1

Project Title		Project Dragon
Drawing Title		Warehouse - Markups
Drawing Number		
Revision 00	Date	03.08.2023
Drawn by	Jessica Price	
Reviewed by	Jon Preston	
		PartB Group Pera Business Park Nottingham Road Melton Mowbray LE13 0PB
		PART B

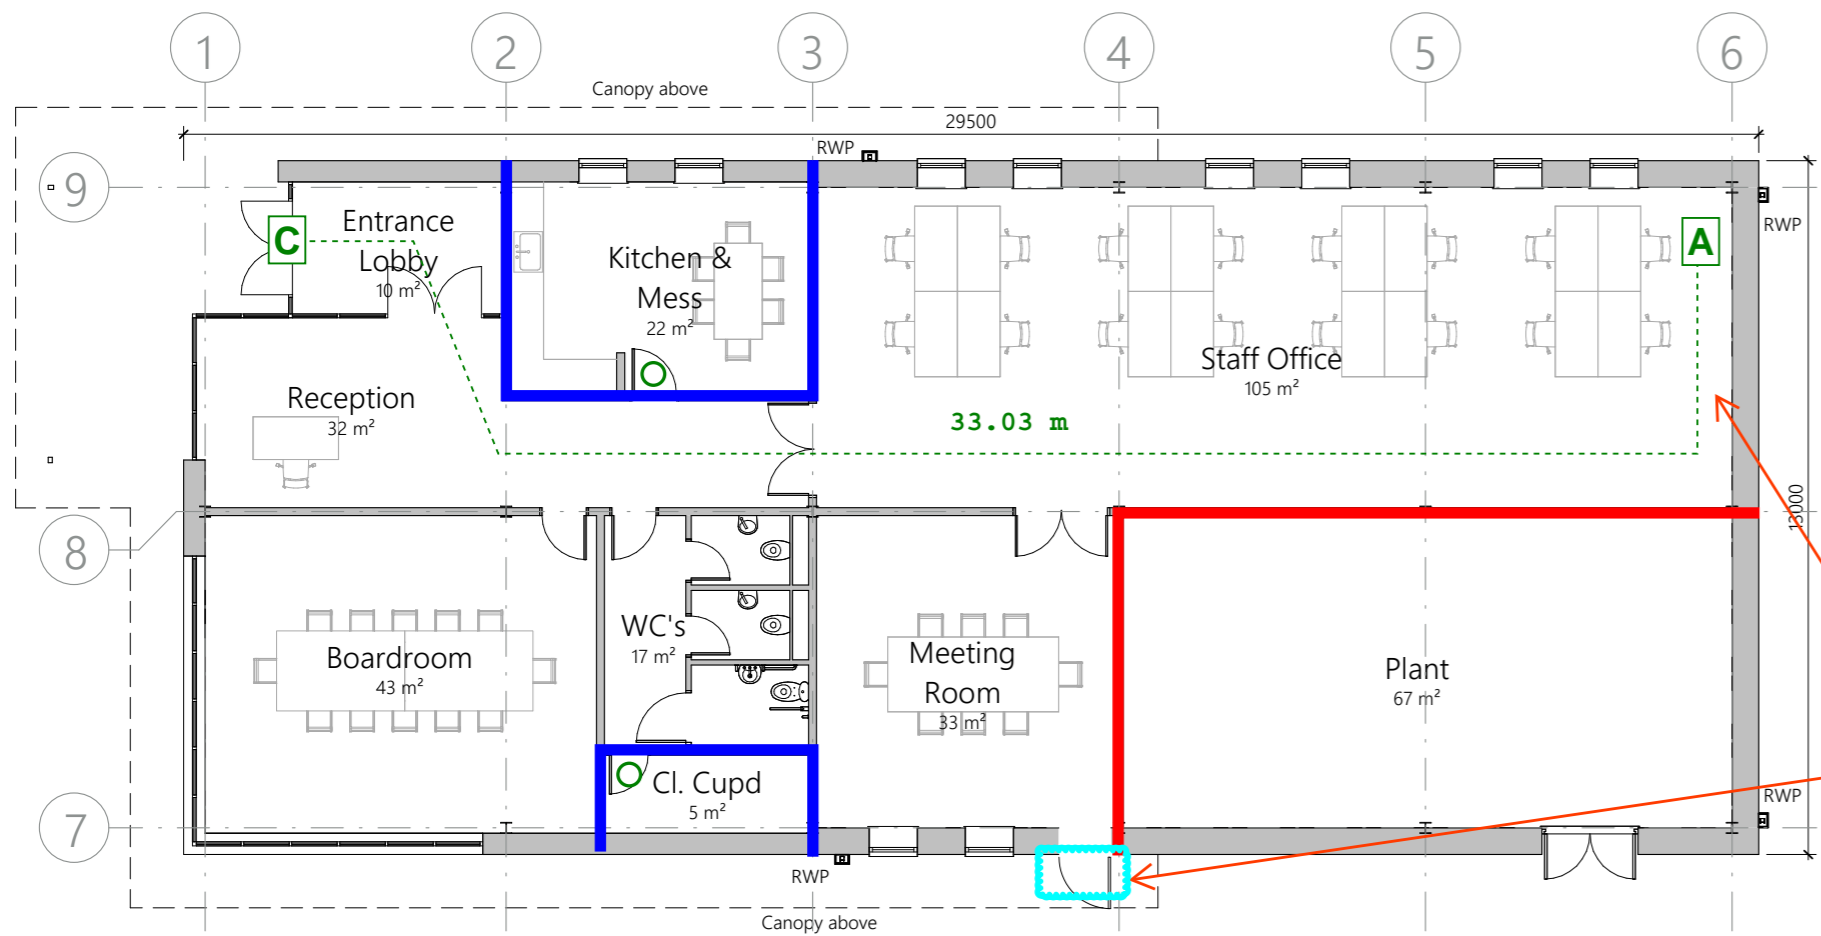

1 Proposed Ground Floor Plan
1:100

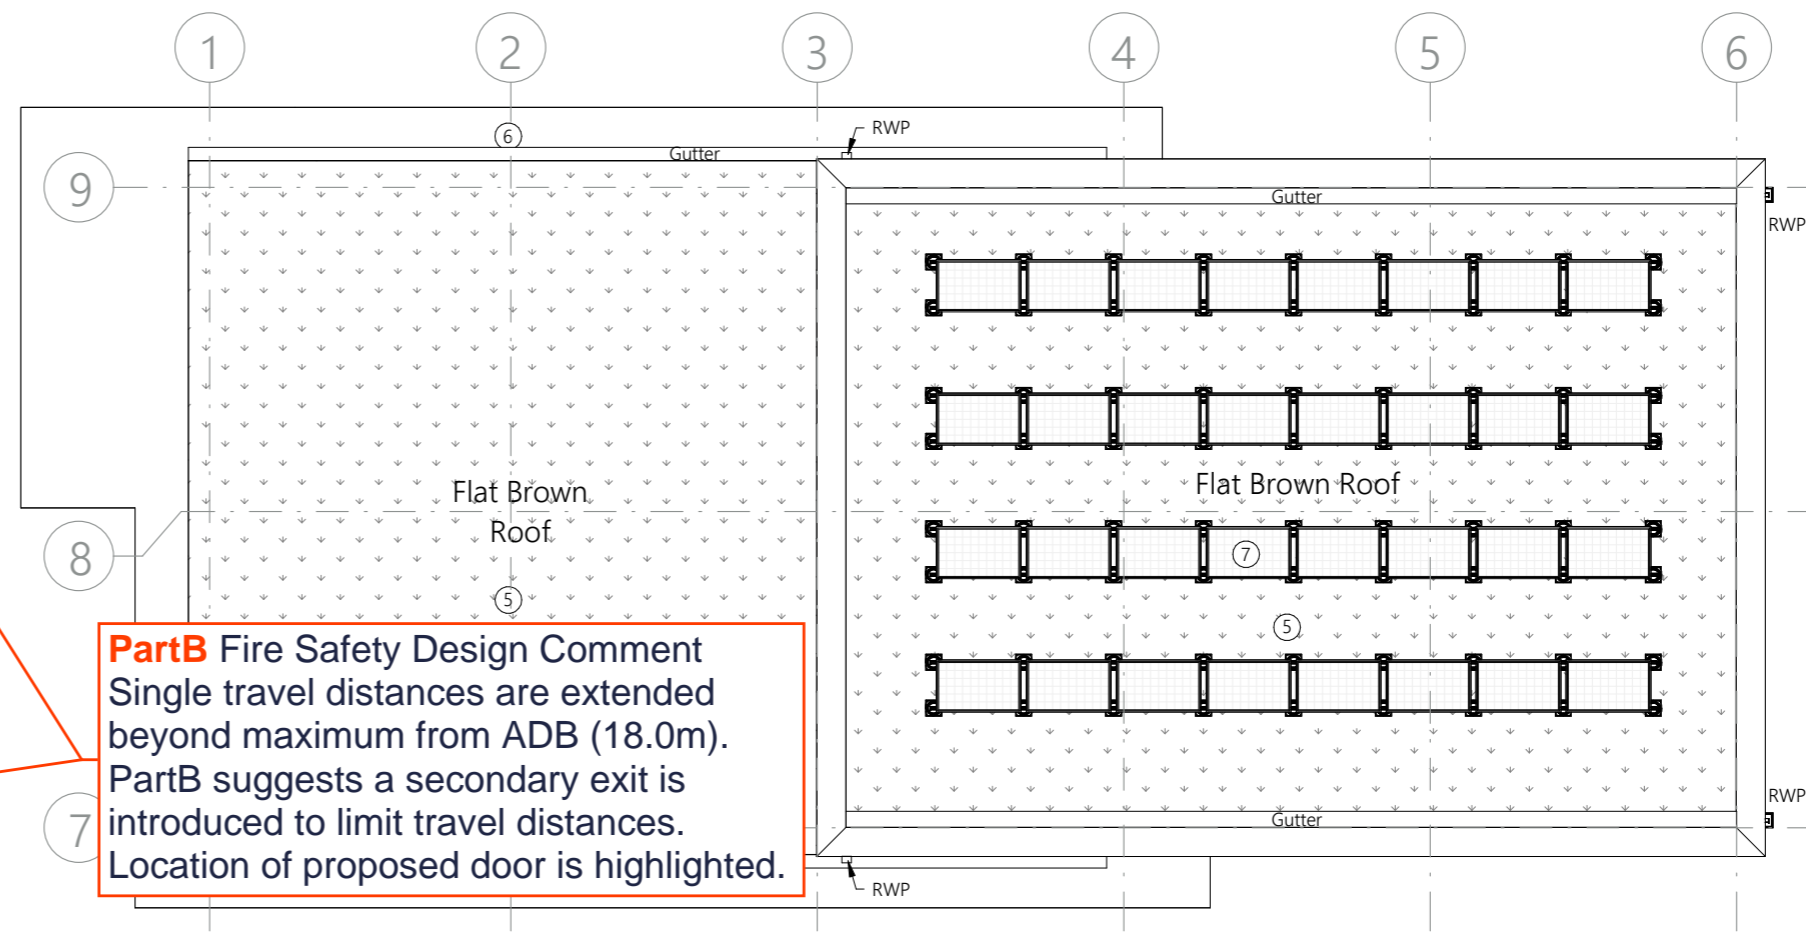


2 Proposed First Floor Plan
1:100

PartB Fire Safety Design Comment
Single travel distances are extended beyond maximum from ADB (18.0m). PartB suggests a secondary exit is introduced to limit travel distances. Location of proposed door is highlighted.


Legend

- FD30 Fire Door
- 30 minutes Fire Rated Construction
- 60 minutes Fire Rated Construction
- Proposed additional door
- Travel Distance


NOTES
• North arrow above indicates 'True North'

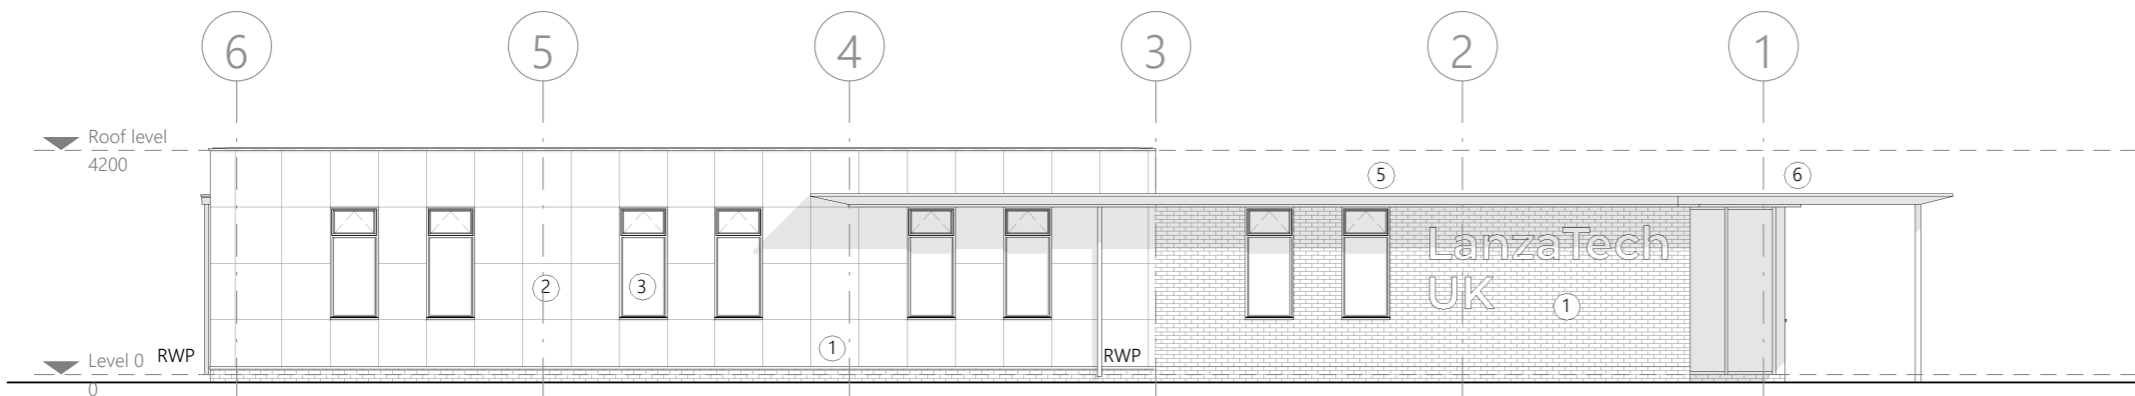

3 Proposed North Elevation
1:100

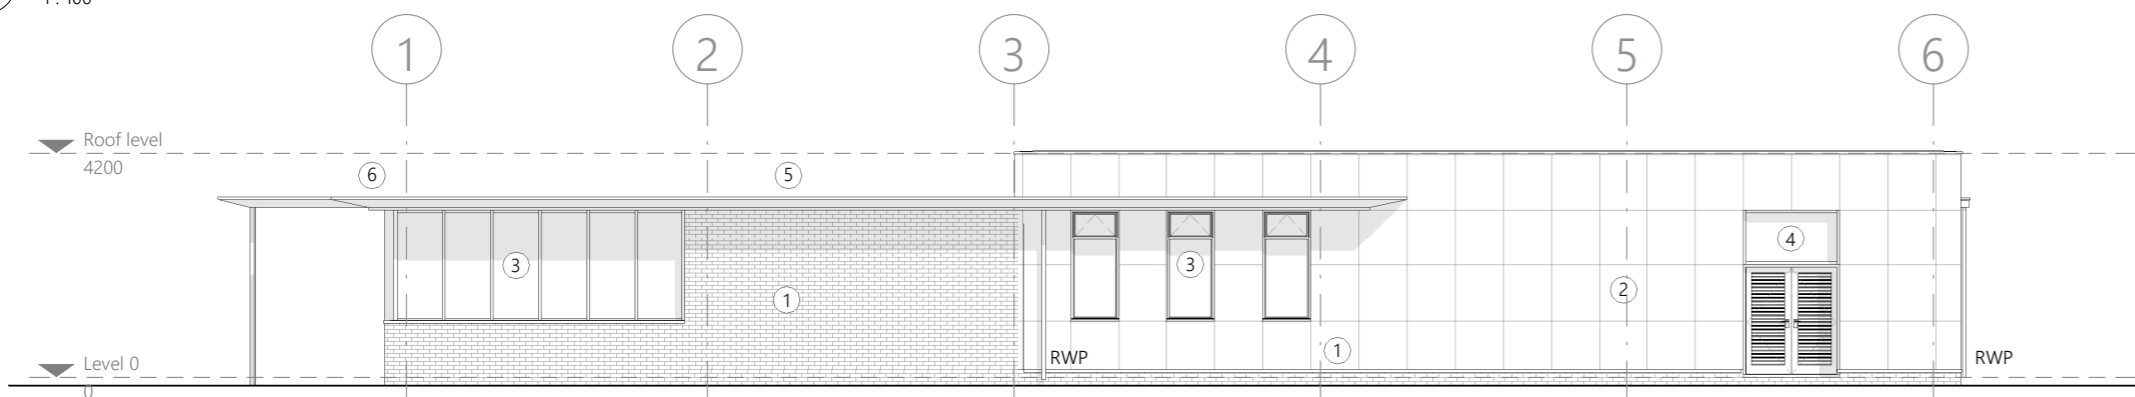

4 Proposed South Elevation
1:100

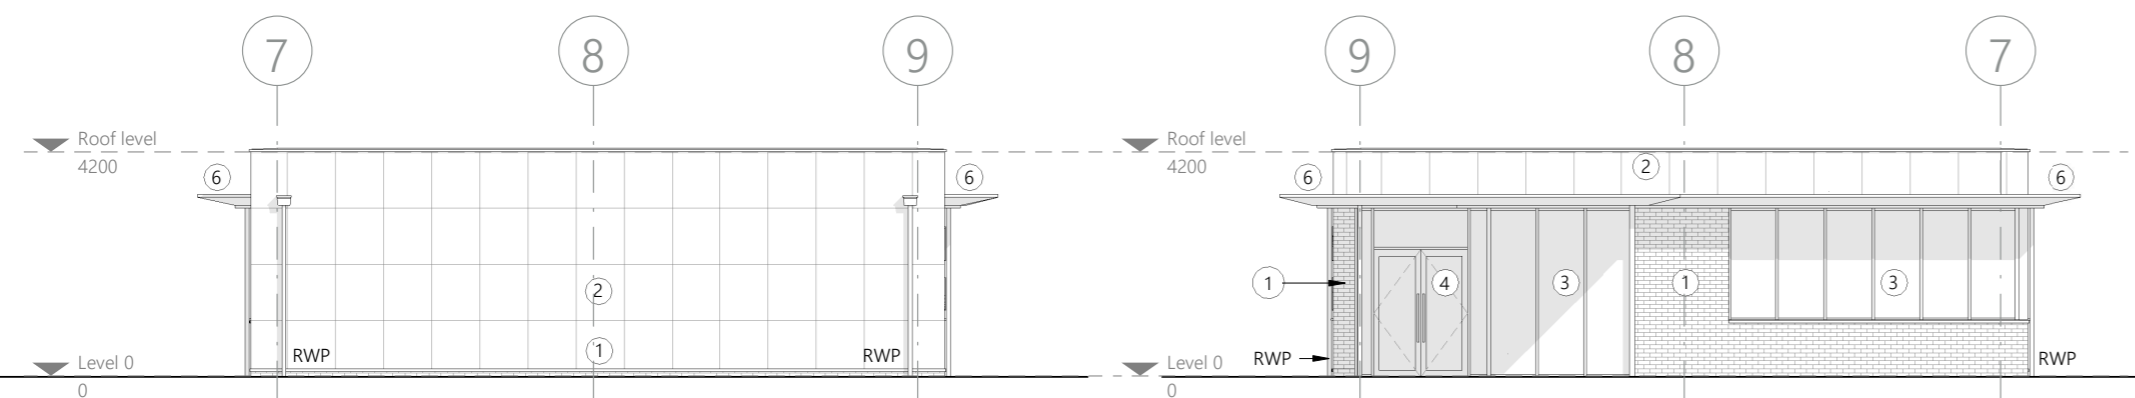

5 Proposed East Elevation
1:100

6 Proposed West Elevation
1:100




7 Admin Building 3D View 1




8 Admin Building 3D View 2

Project Title		Project Dragon
Drawing Title		Admin Building 1 - Markups
Drawing Number		
Revision 00	Date	03.08.2023
Drawn by		Jessica Price
Reviewed by		Jon Preston
PartB Group Pera Business Park Nottingham Road Melton Mowbray LE13 0PB		
PART B		

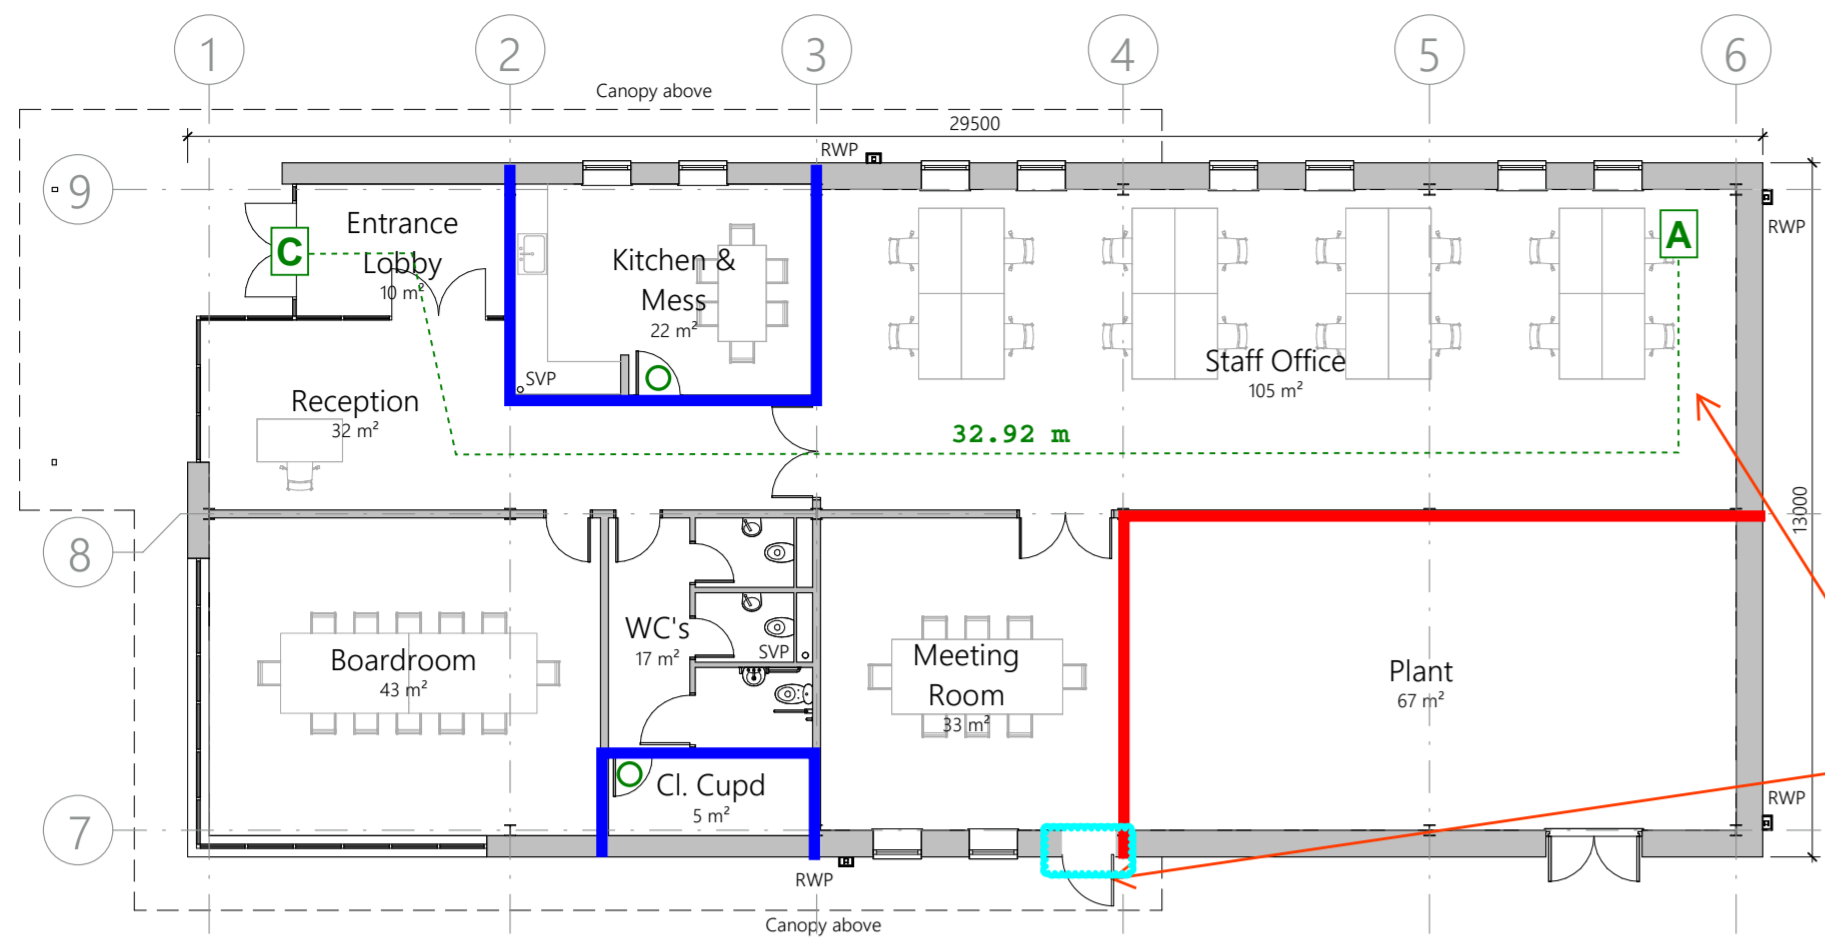

1 Proposed Ground Floor Plan
1:100

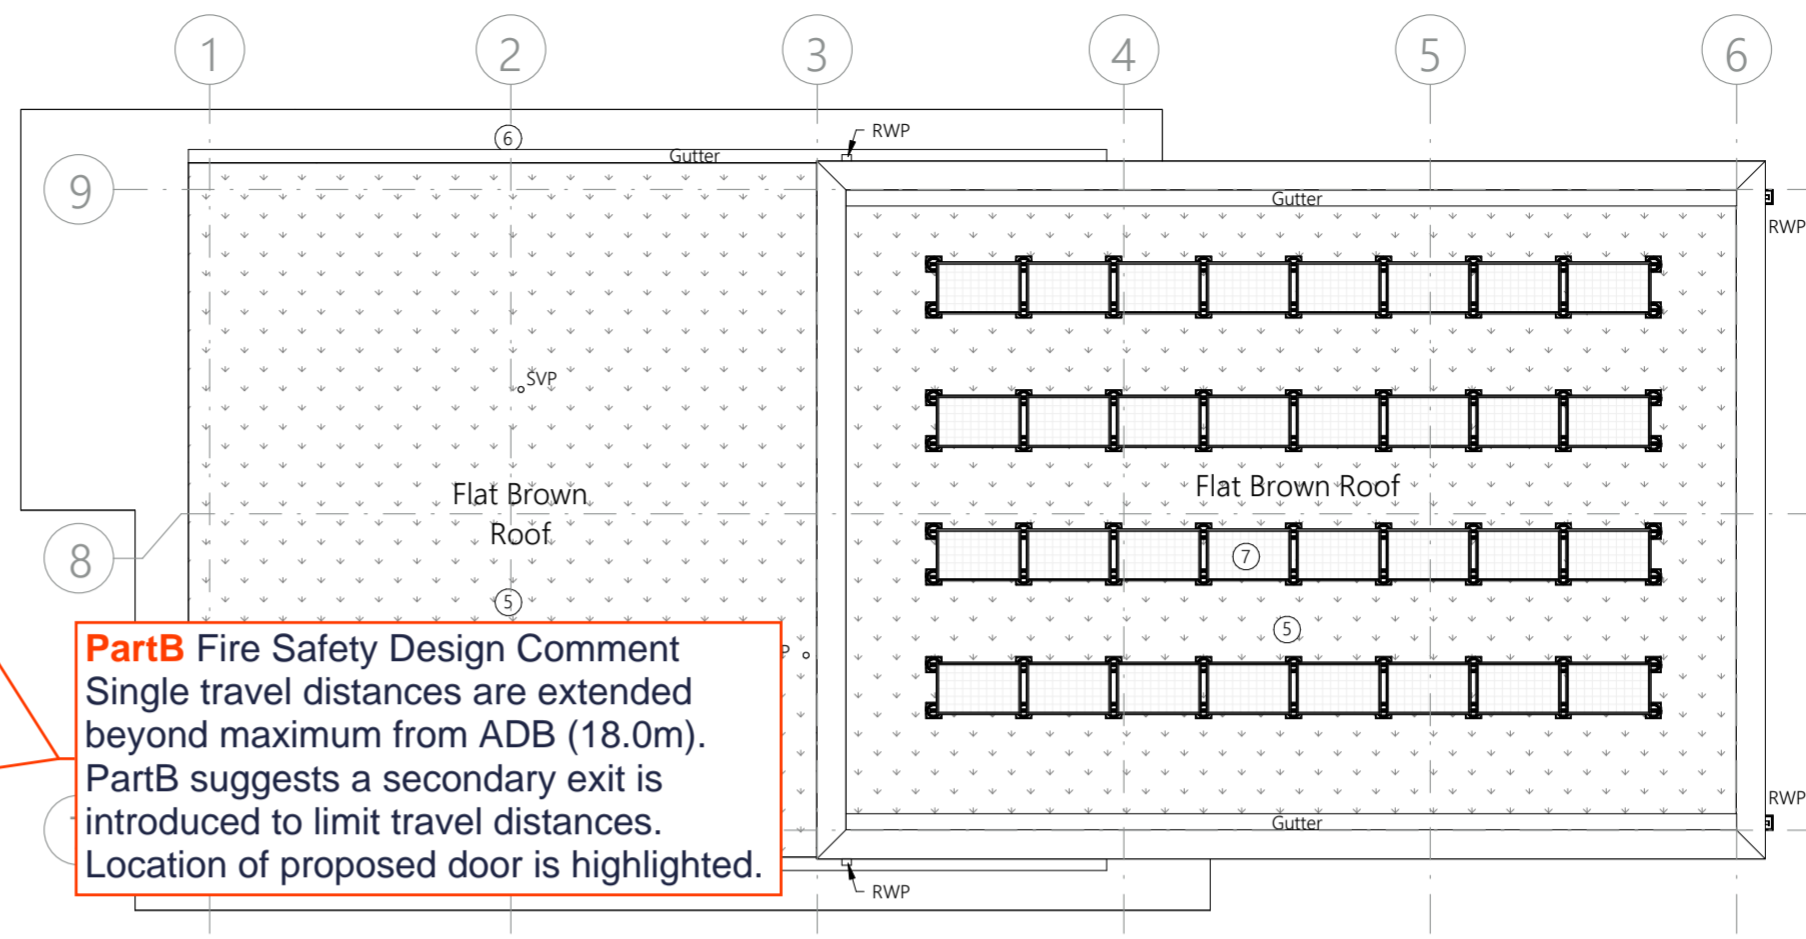


2 Proposed First Floor Plan
1:100

PartB Fire Safety Design Comment
Single travel distances are extended beyond maximum from ADB (18.0m). PartB suggests a secondary exit is introduced to limit travel distances. Location of proposed door is highlighted.


Legend

- FD30 Fire Door
- 30 minutes Fire Rated Construction
- 60 minutes Fire Rated Construction
- Proposed additional door
- Travel Distance


NOTES
• North arrow above indicates 'True North'

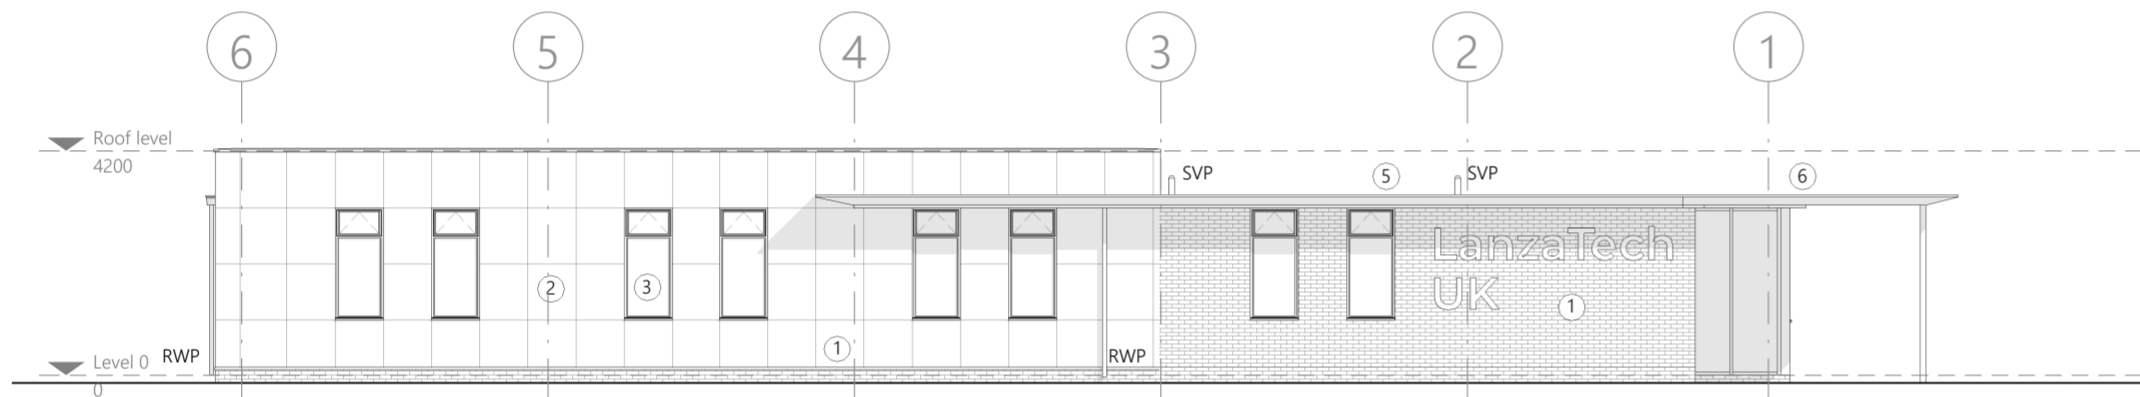


3 Proposed North Elevation
1:100

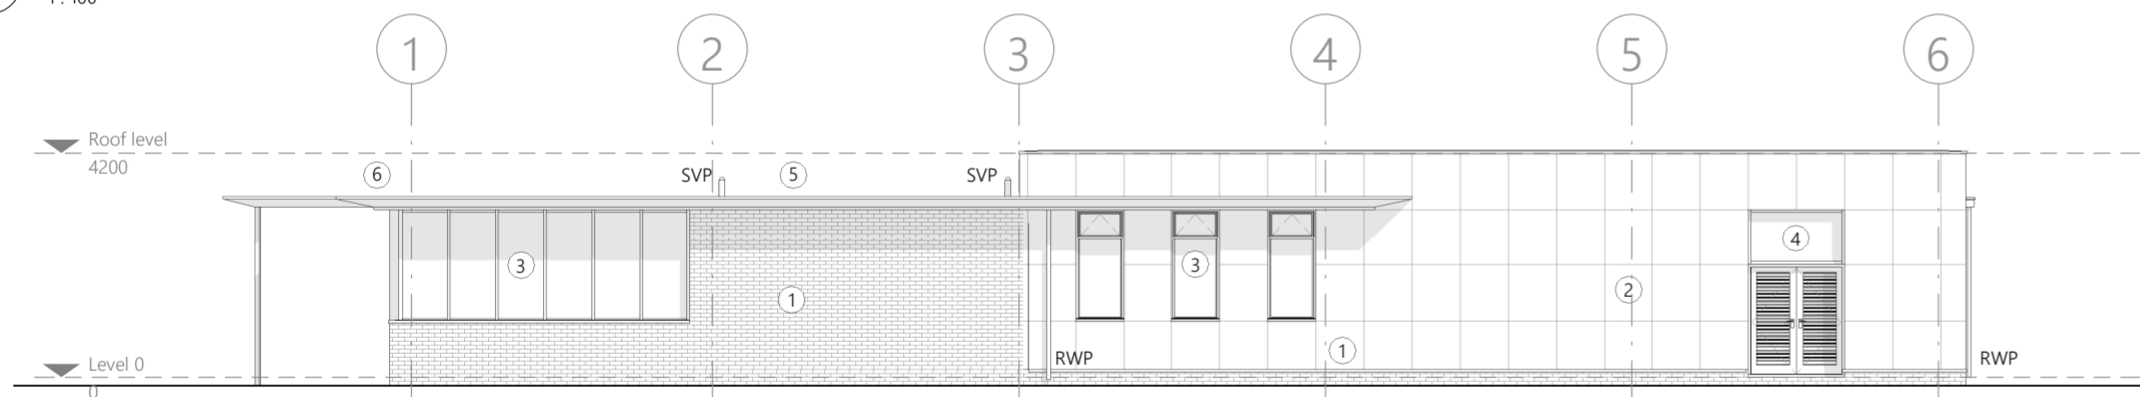

4 Proposed South Elevation
1:100

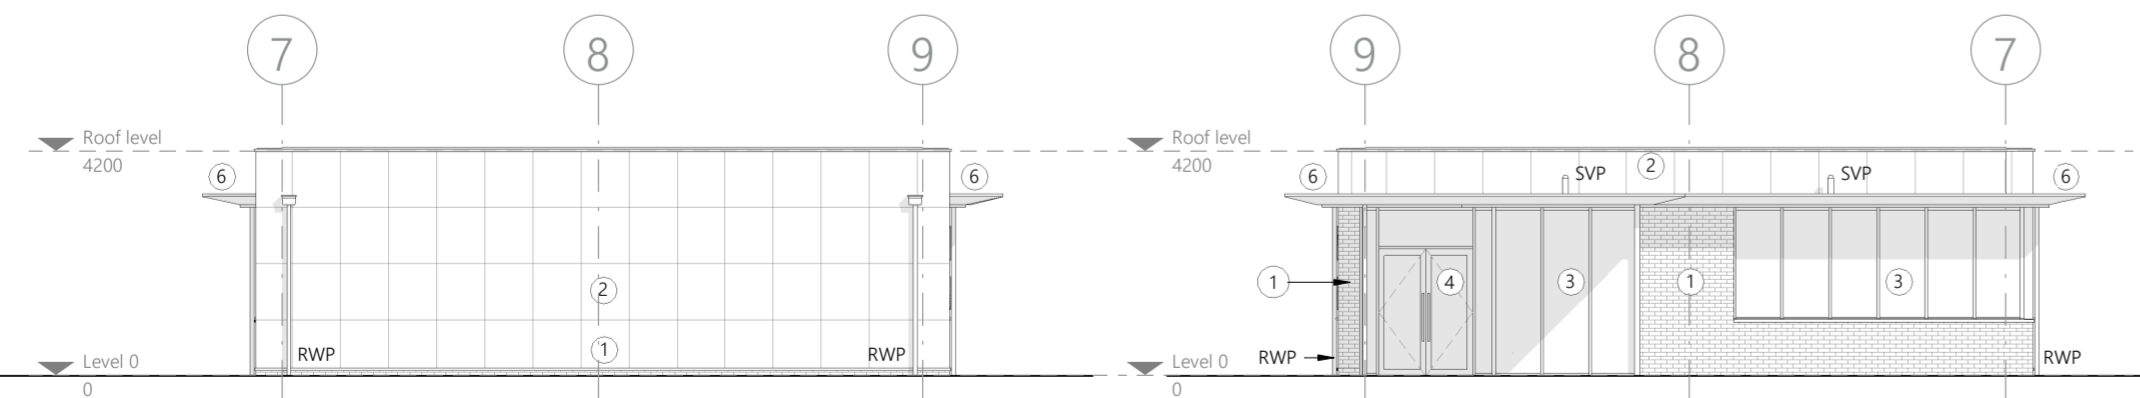


5 Proposed East Elevation
1:100

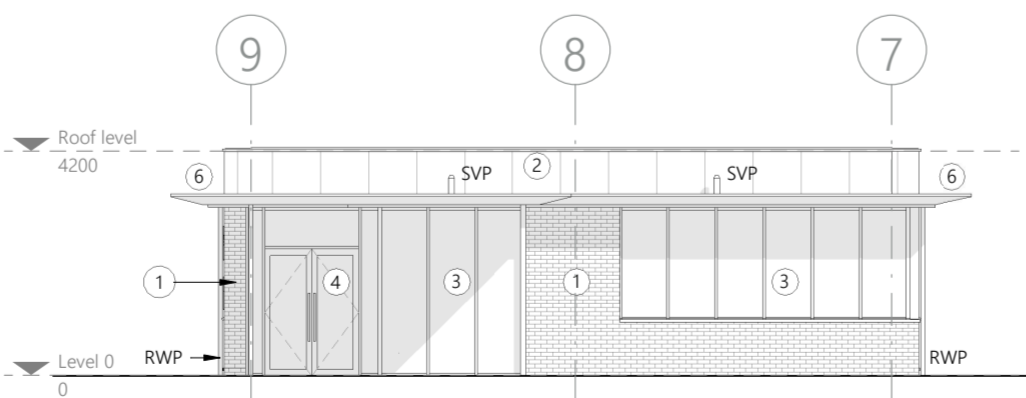

6 Proposed West Elevation
1:100



7 Admin Building 3D View 1

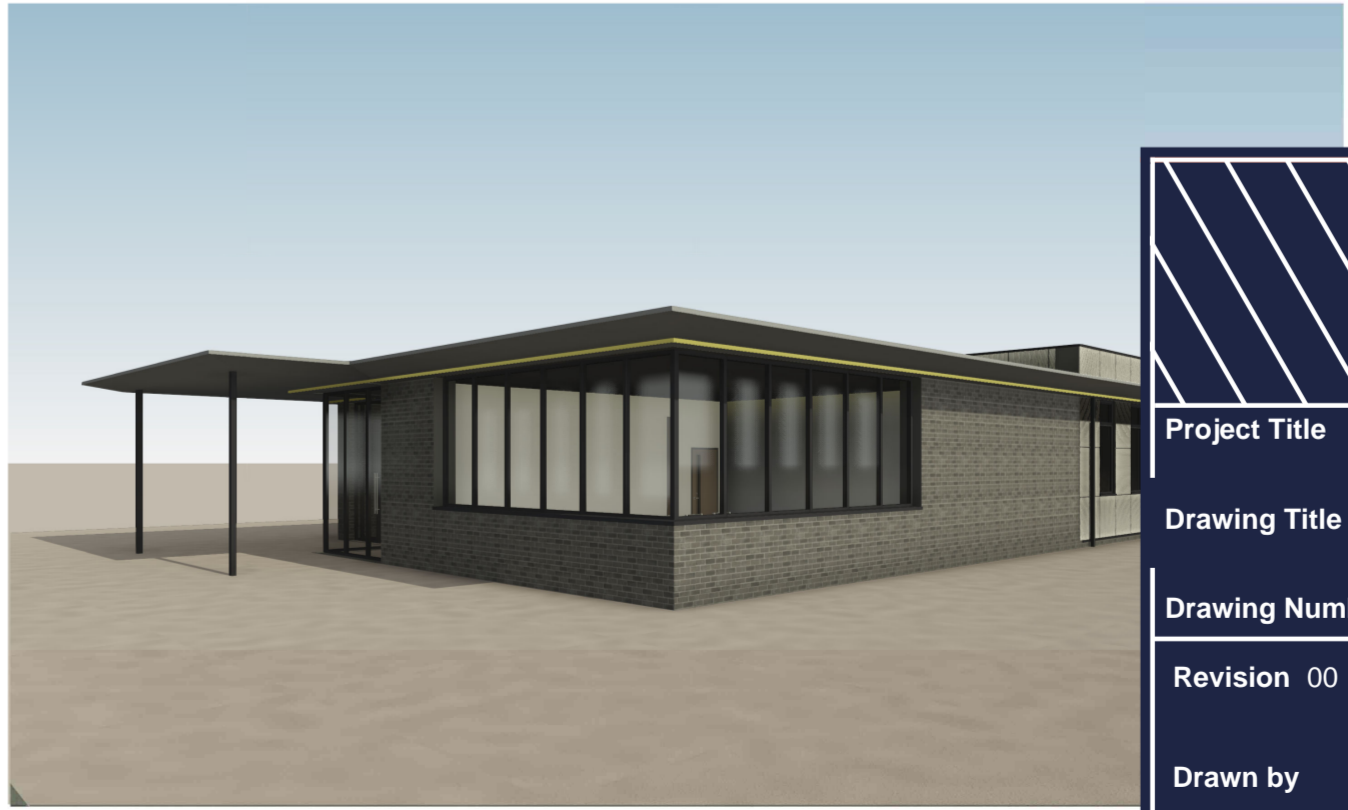


8 Admin Building 3D View 2

Project Title		Project Dragon	
Drawing Title		Admin Building 2 - Markups	
Drawing Number			
Revision 00	Date	03.08.2023	PartB Group Pera Business Park Nottingham Road Melton Mowbray LE13 0PB
Drawn by	Jessica Price		
Reviewed by		Jon Preston	




- Legend**
- Notational boundary to equipment on site
 - Boundary between buildings
 - Site boundary
 - 60 minutes Fire Resistant Construction

External Boundaries

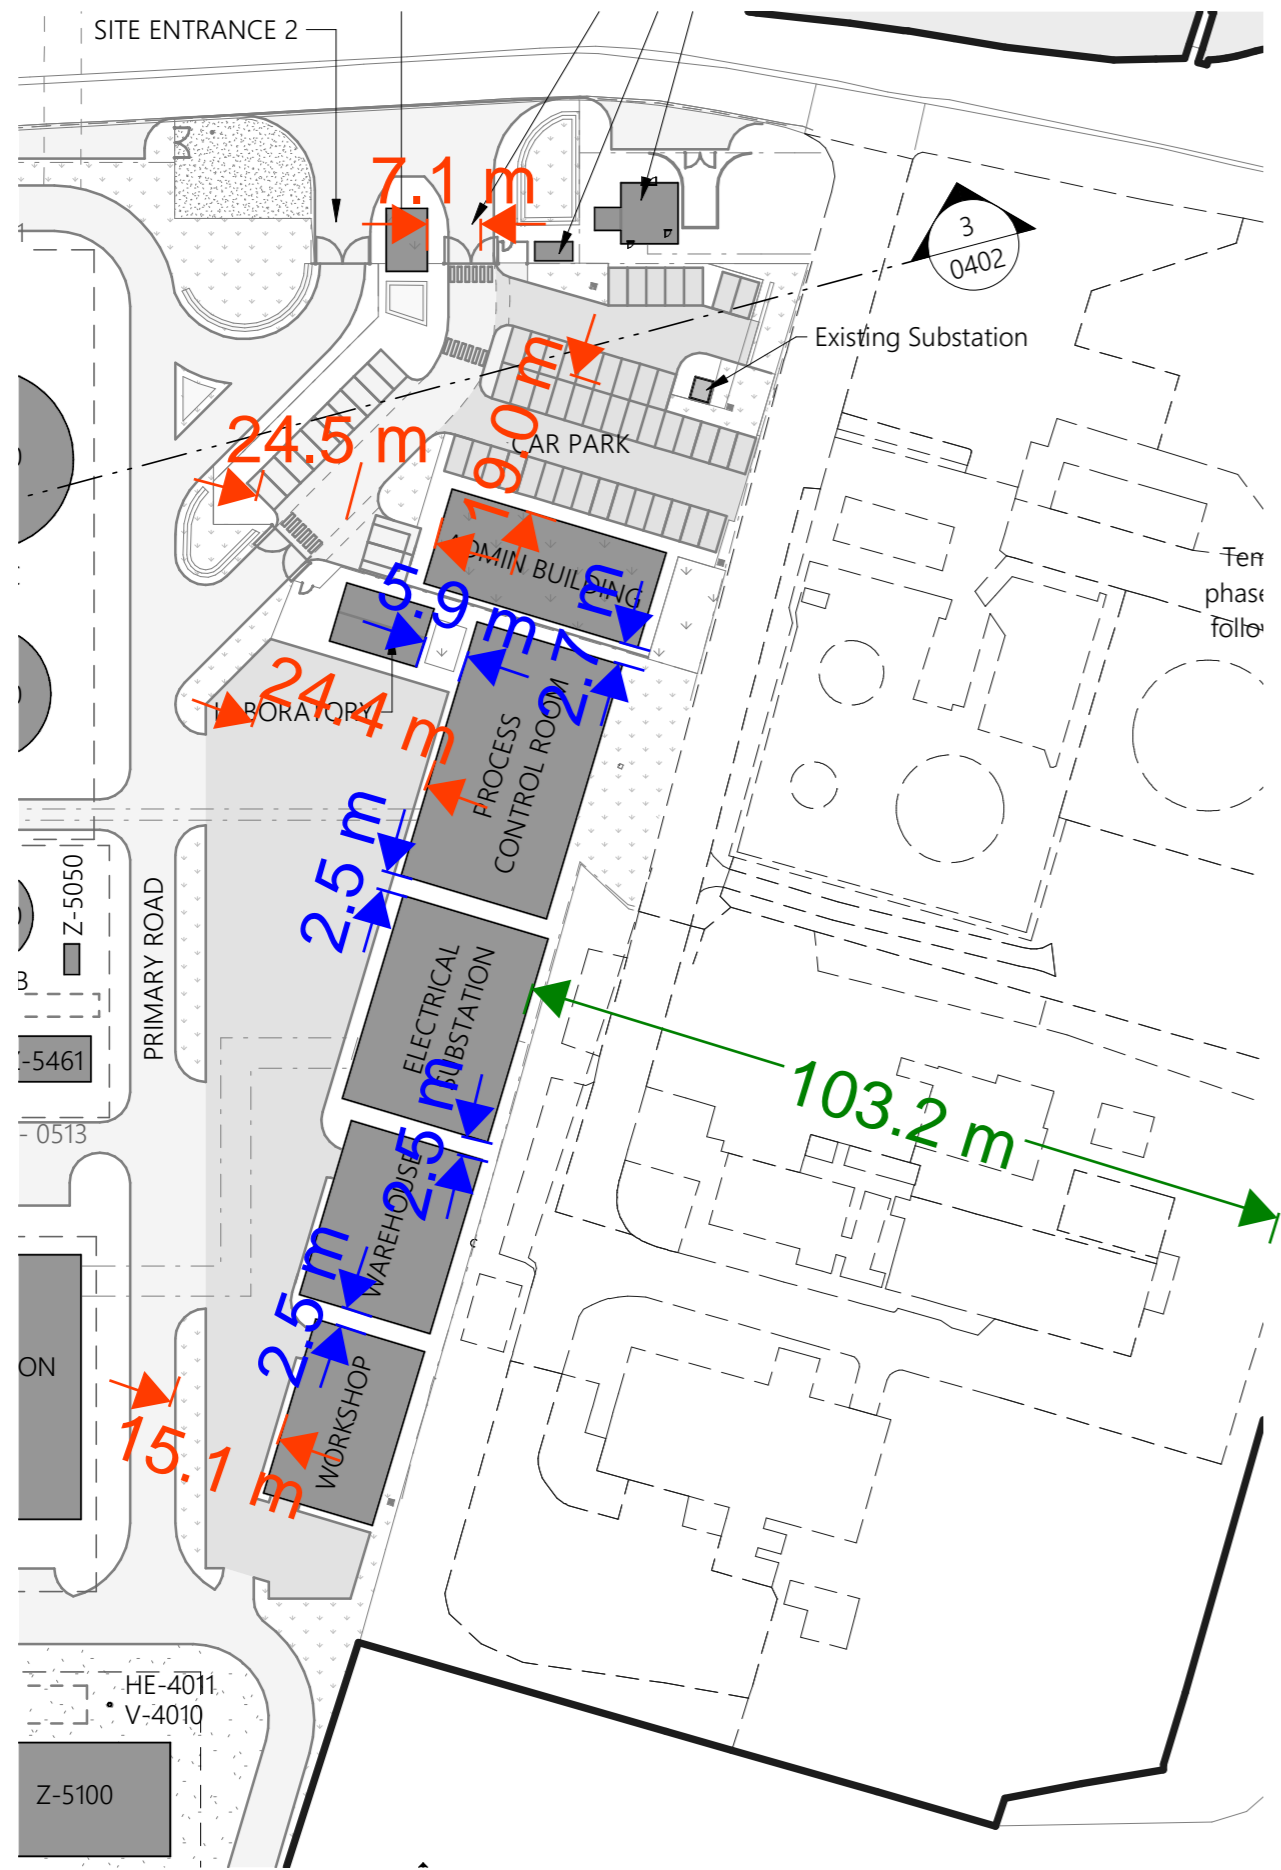



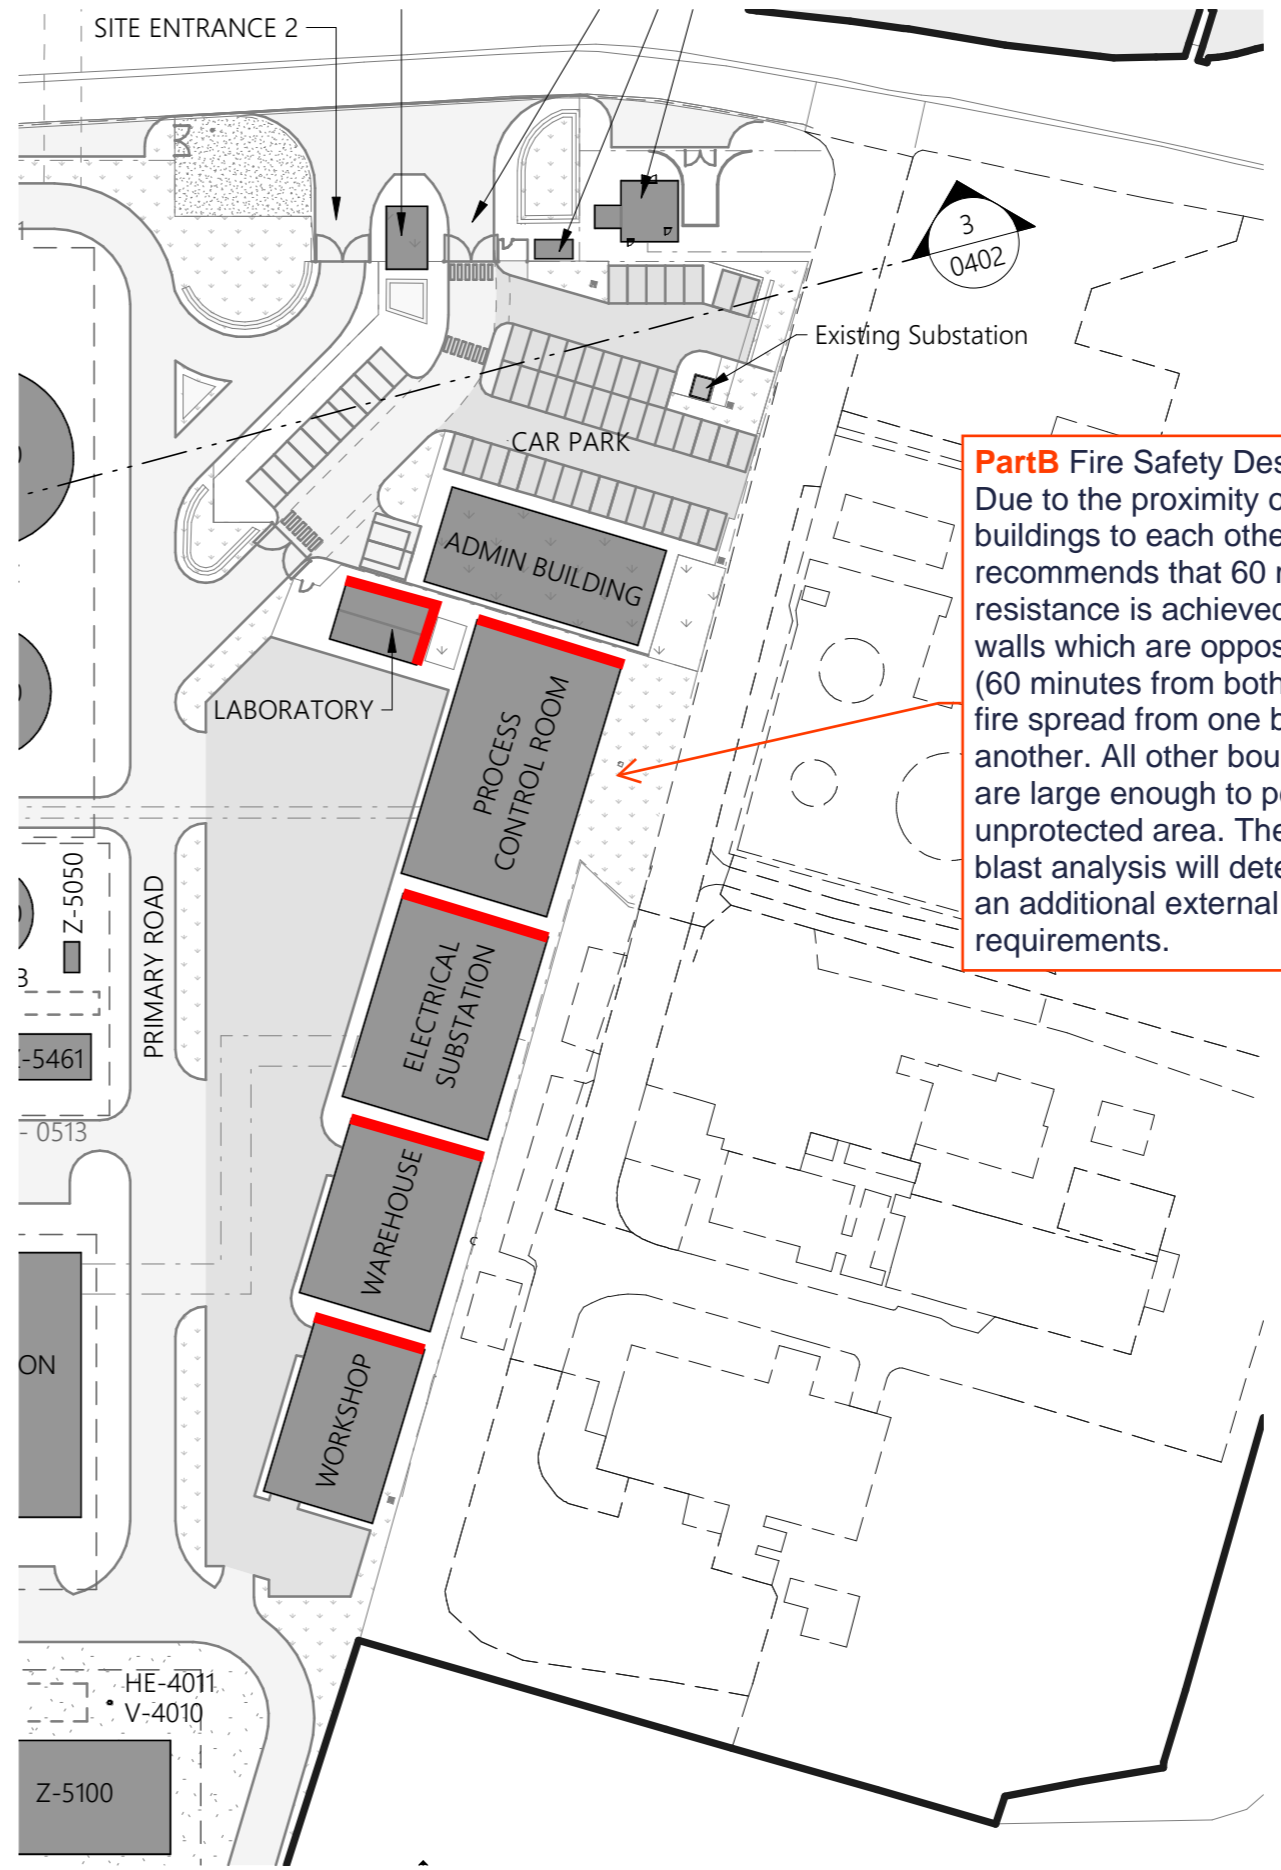

External wall fire resistance




PartB Fire Safety Design Comment
 Due to the proximity of the individual buildings to each other, PartB recommends that 60 minutes fire resistance is achieved for one of the walls which are opposite each other (60 minutes from both sides), to stop fire spread from one building to another. All other boundary distances are large enough to permit 100% unprotected area. The results from the blast analysis will determine if there are an additional external wall requirements.

Project Title		Project Dragon	
Drawing Title		External Fire Spread Review	
Drawing Number			
Revision 00	Date 03.08.2023	PartB Group Pera Business Park Nottingham Road Melton Mowbray LE13 0PB	
Drawn by Jessica Price		Reviewed by Jon Preston	
PART B			

Part B - Fire Service Access Key

-  Fire appliance parking position
-  Fire appliance route
-  Actual building perimeter
-  Accessible building perimeter

PartB Fire Safety Design Comment
Location of Hydrants to be confirmed.

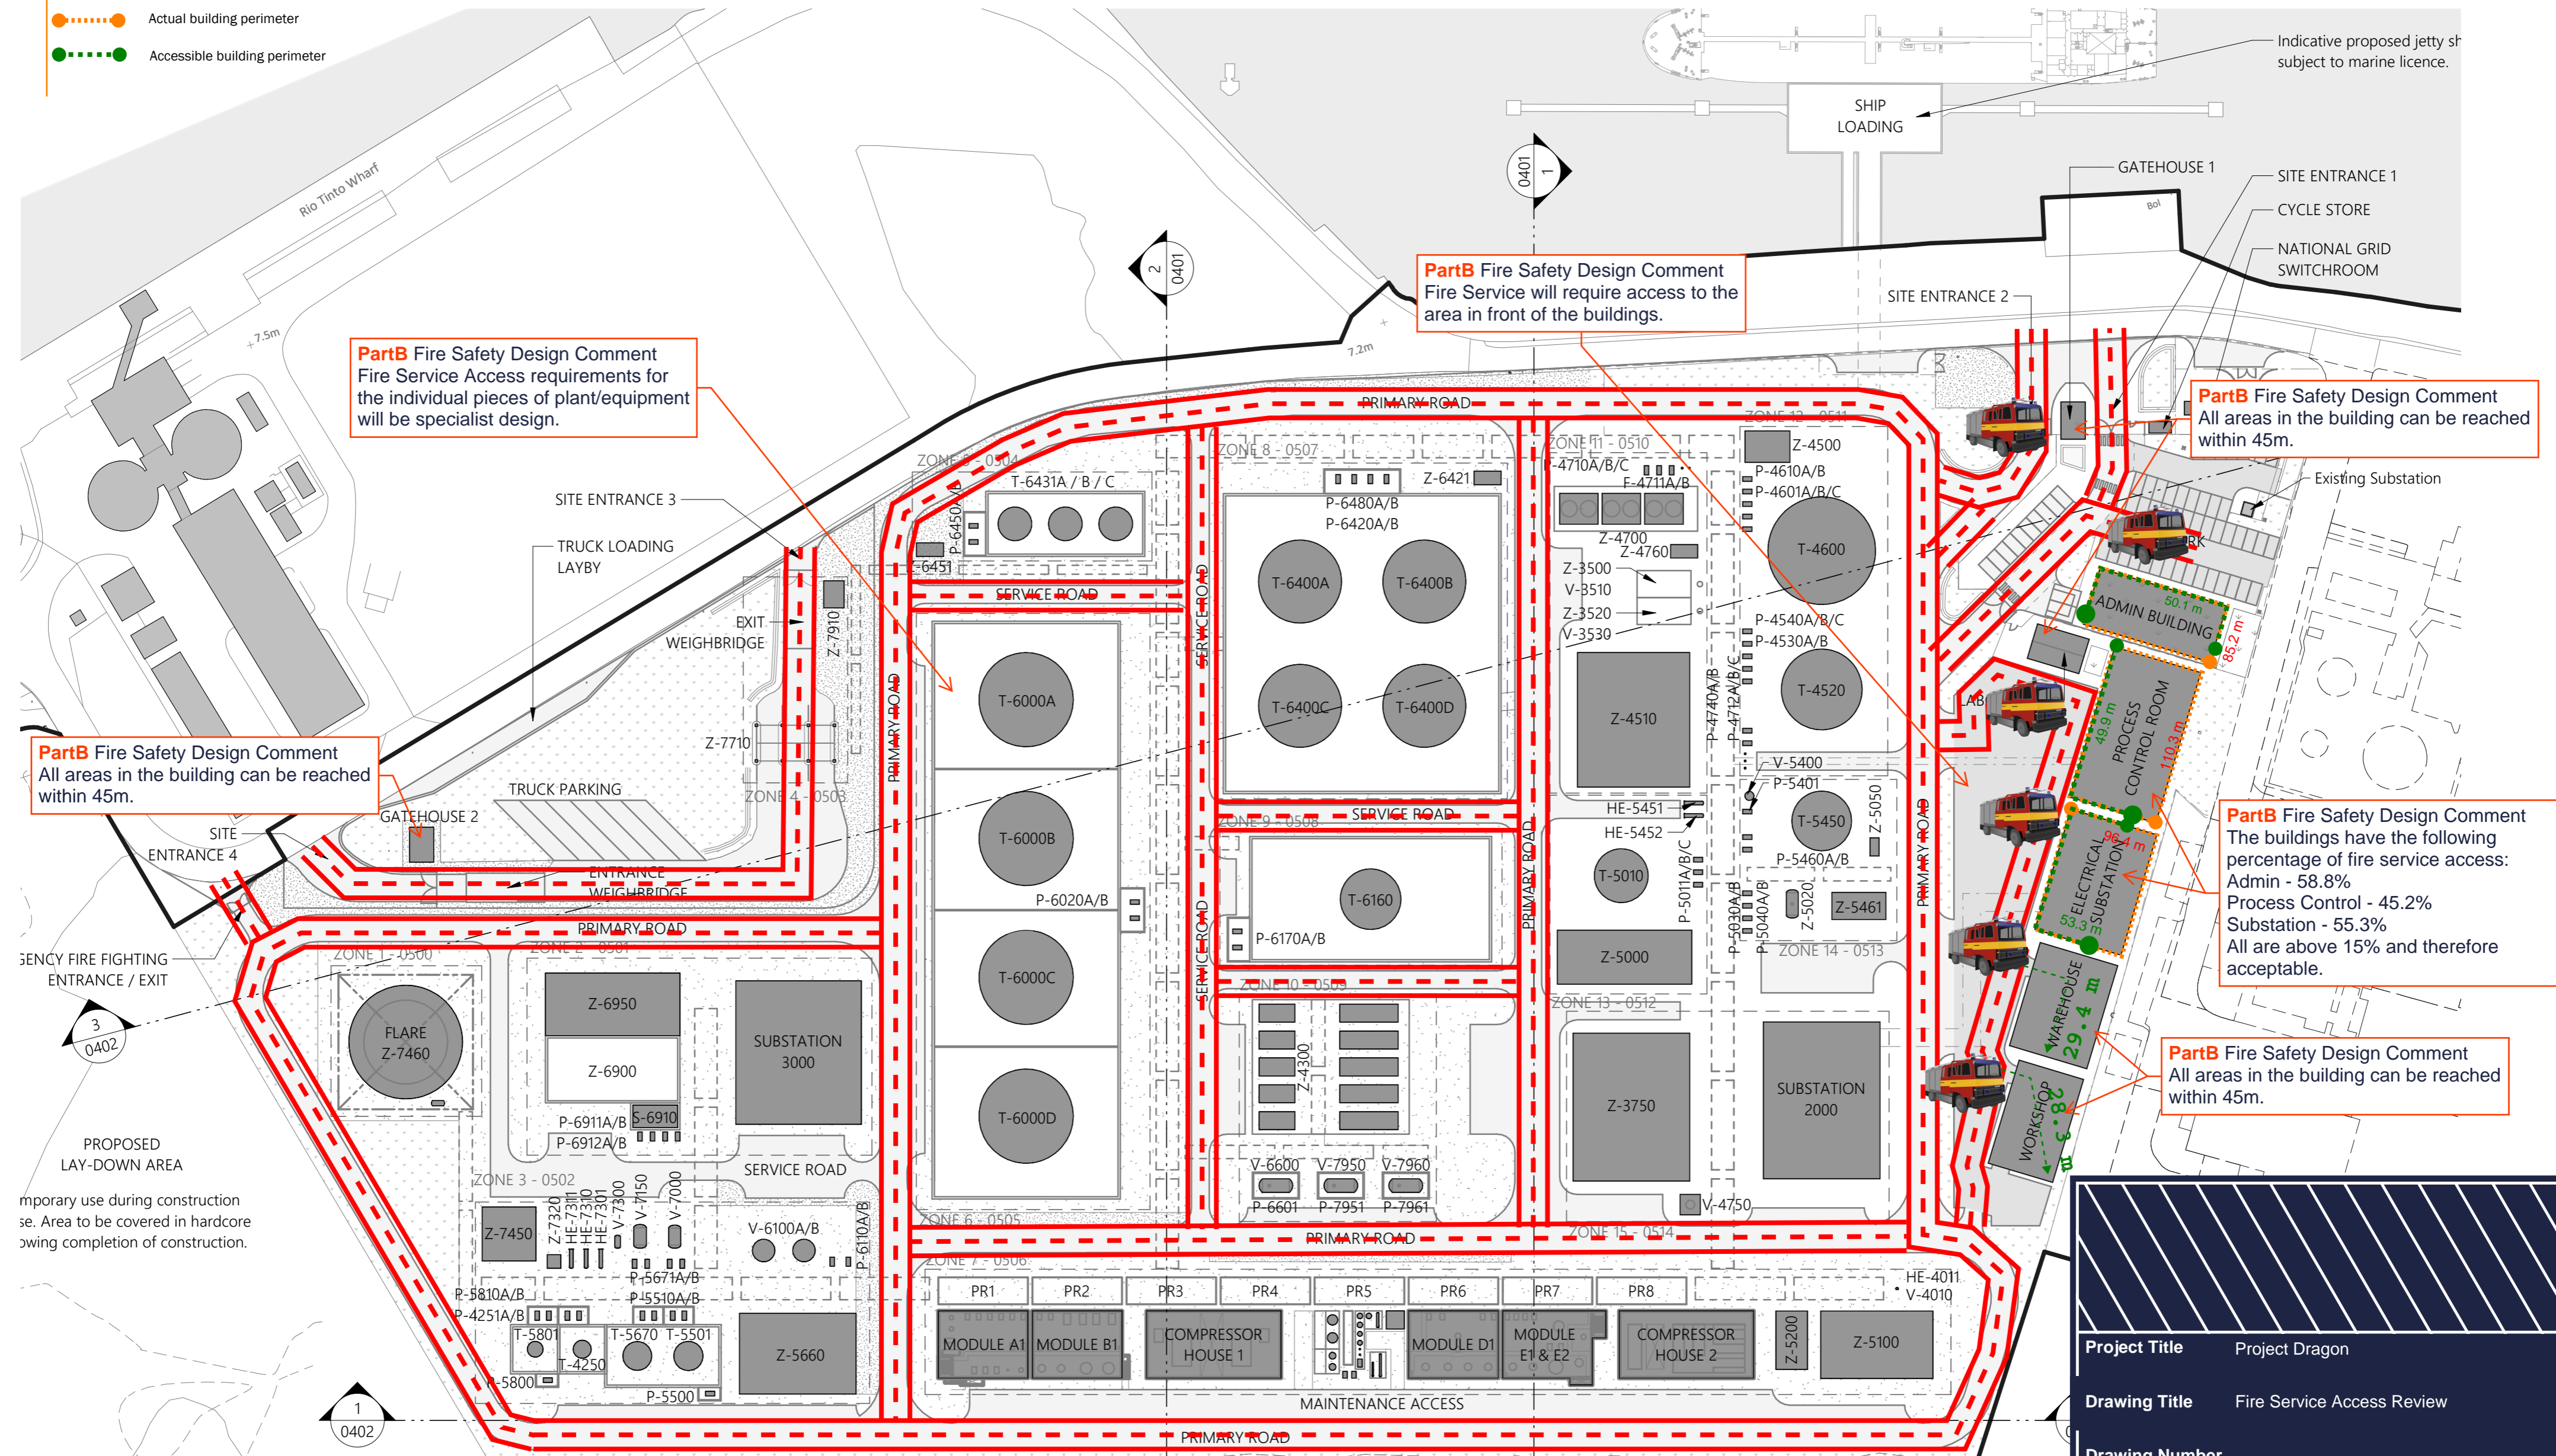

PartB Fire Safety Design Comment
Fire Service Access requirements for the individual pieces of plant/equipment will be specialist design.

PartB Fire Safety Design Comment
Fire Service will require access to the area in front of the buildings.

PartB Fire Safety Design Comment
All areas in the building can be reached within 45m.

PartB Fire Safety Design Comment
All areas in the building can be reached within 45m.

PartB Fire Safety Design Comment
The buildings have the following percentage of fire service access:
Admin - 58.8%
Process Control - 45.2%
Substation - 55.3%
All are above 15% and therefore acceptable.

PartB Fire Safety Design Comment
All areas in the building can be reached within 45m.

Project Title	Project Dragon		
Drawing Title	Fire Service Access Review		
Drawing Number			
Revision 00	Date	03.08.2023	PartB Group Pera Business Park Nottingham Road Melton Mowbray LE13 0PB
Drawn by	Jessica Price		
Reviewed by	Jon Preston		

